



T.2N. R. 3W.W.M.

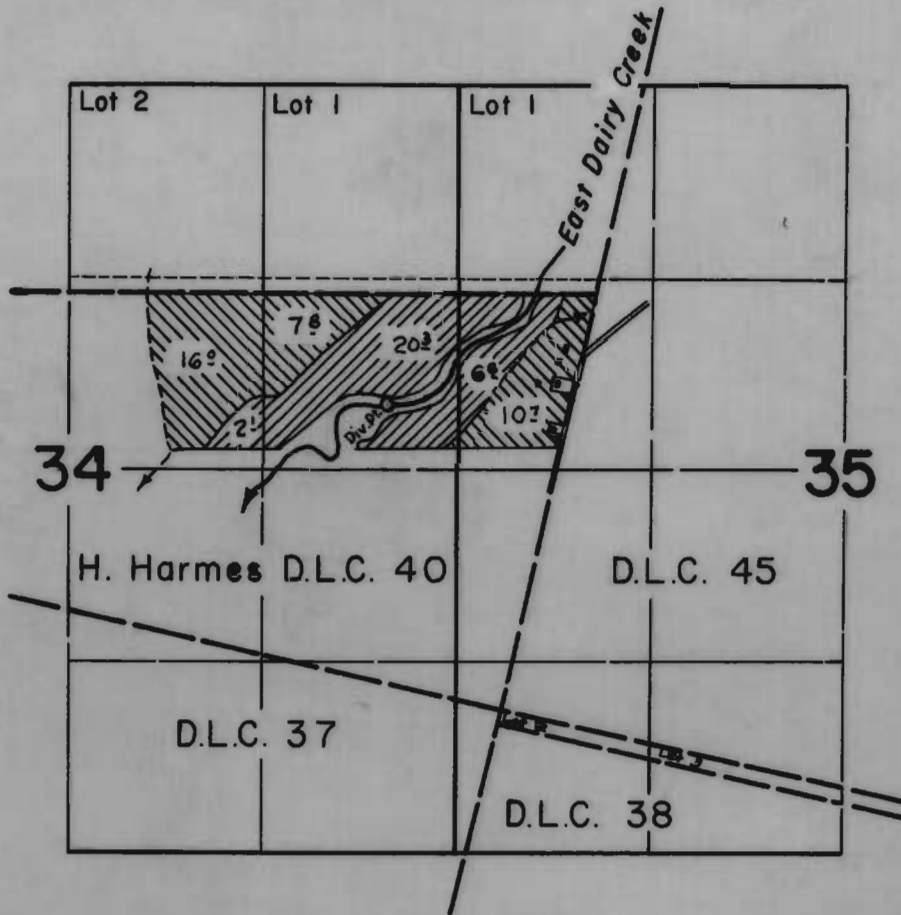

FINAL PROOF SURVEY UNDER

Application No. ²⁶¹⁶⁶ 28472 Permit No. ²¹²⁴⁸ 22299 
IN NAME OF

Omer A. Vandehey

Surveyed August 2, 1960., by 