

## FINAL PROOF SURVEY

UNDER

Application No. G-5140 Permit No. G-4873

IN NAME OF


FLYING DUTCHMEN LAND & CATTLE CO.

Surveyed Oct. 25, 1974, by L. E. Gould

21.8

6-4873

T.39S. R.11E. W.M.

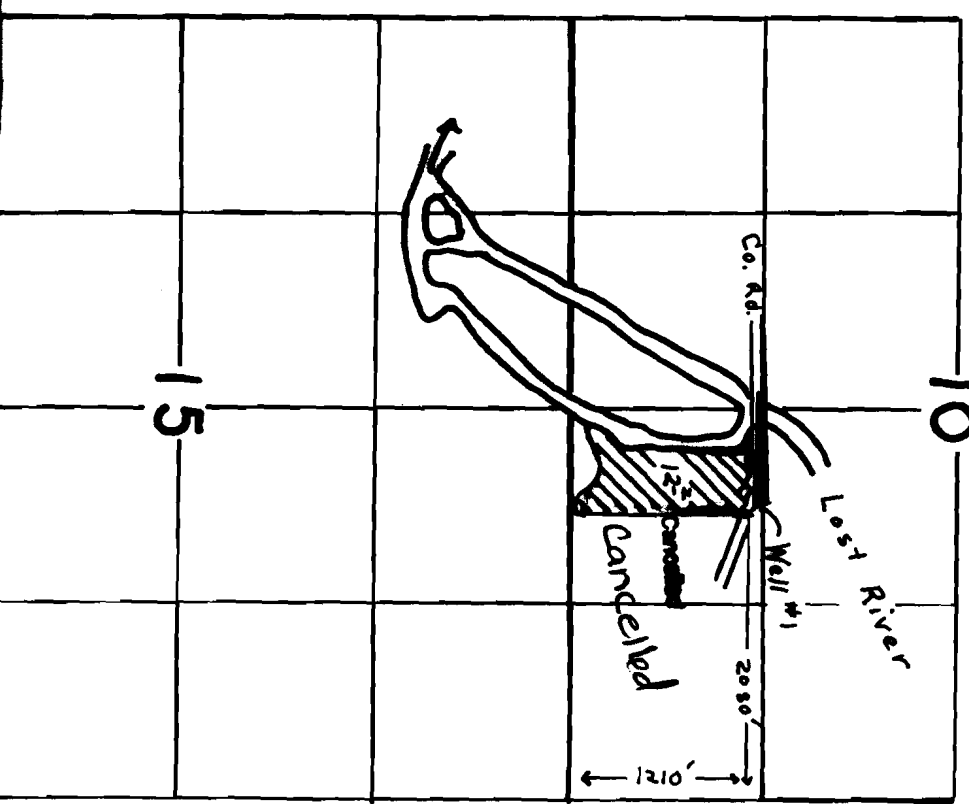

6-4873

