



SECTION 8 & 17, T.1S., R.2W., W.M.

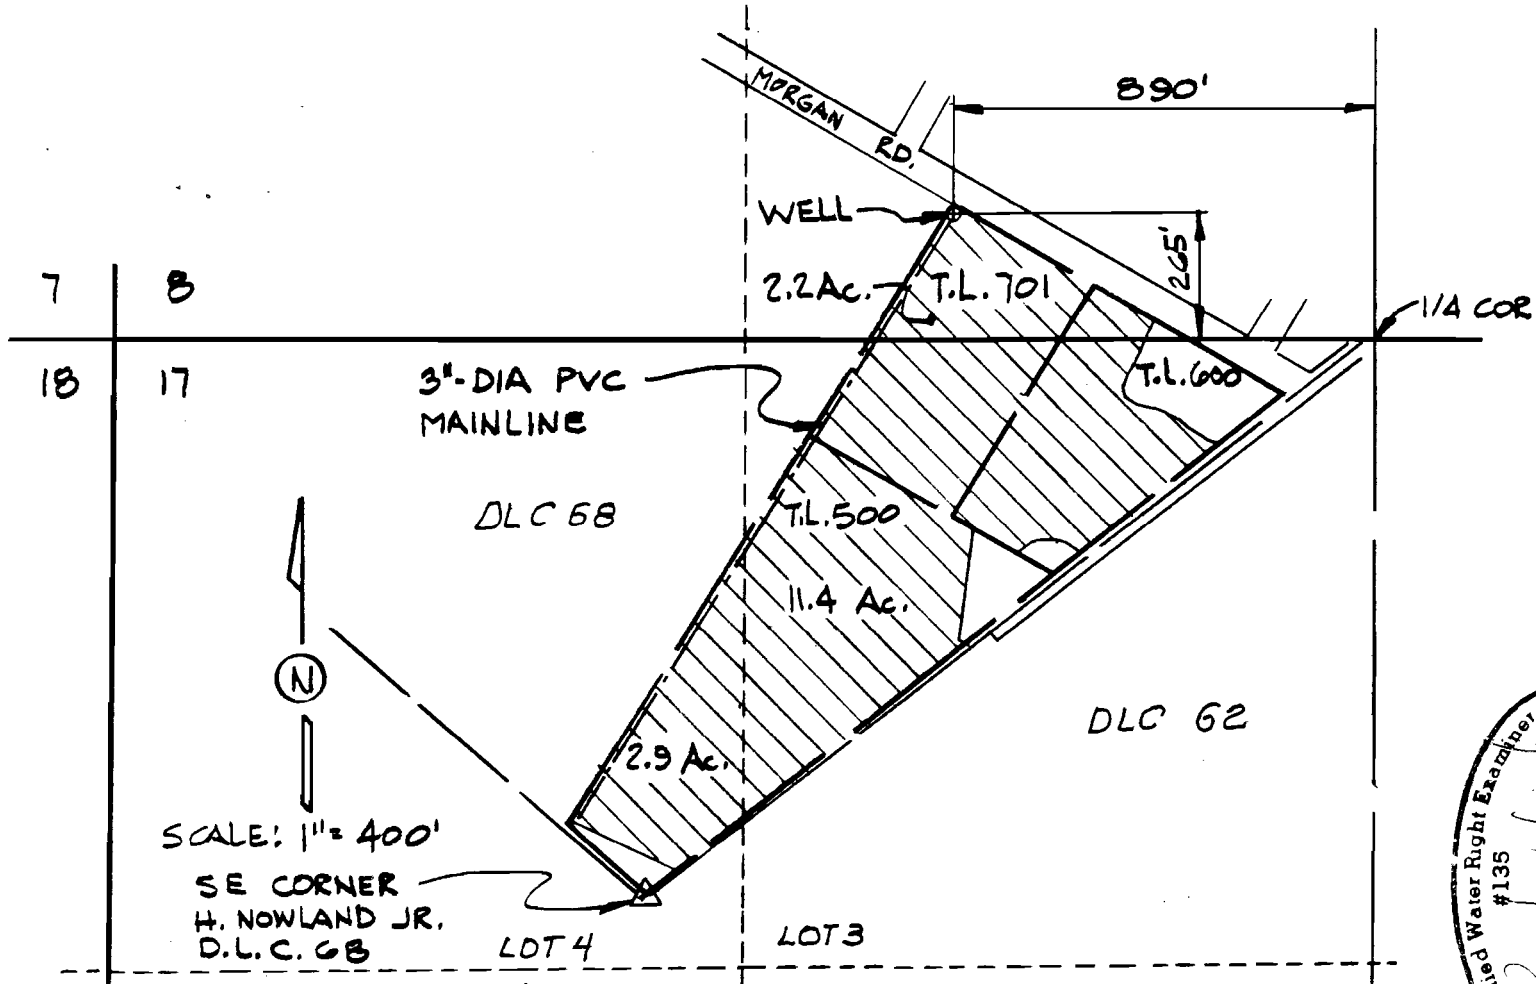

PREPARATION OF THIS MAP IS FOR THE PURPOSE OF IDENTIFYING THE LOCATION OF THE WATER RIGHT ONLY. THERE IS NO INTENT TO PROVIDE DIMENSIONS OR LOCATION OF PROPERTY OWNERSHIP LINES.

**ATSUSHI ENDO
HILLSBORO, OR**

designed	WRV 7-91
drawn	JER 7-91
checked	WRV 7-91
drawing no.	91-A-12
sheet no.	1/1

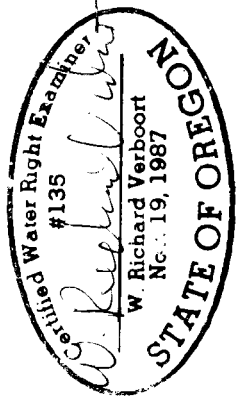

VERBOORT ENGINEERING
 AGRICULTURE-CIVIL-WATER RESOURCES
 HILLSBORO, OREGON

FINAL PROOF SURVEY
 UNDER
 APPLICATION NO. G-11928, PERMIT NO. G-11093
 SURVEYED JULY 12, 1991