
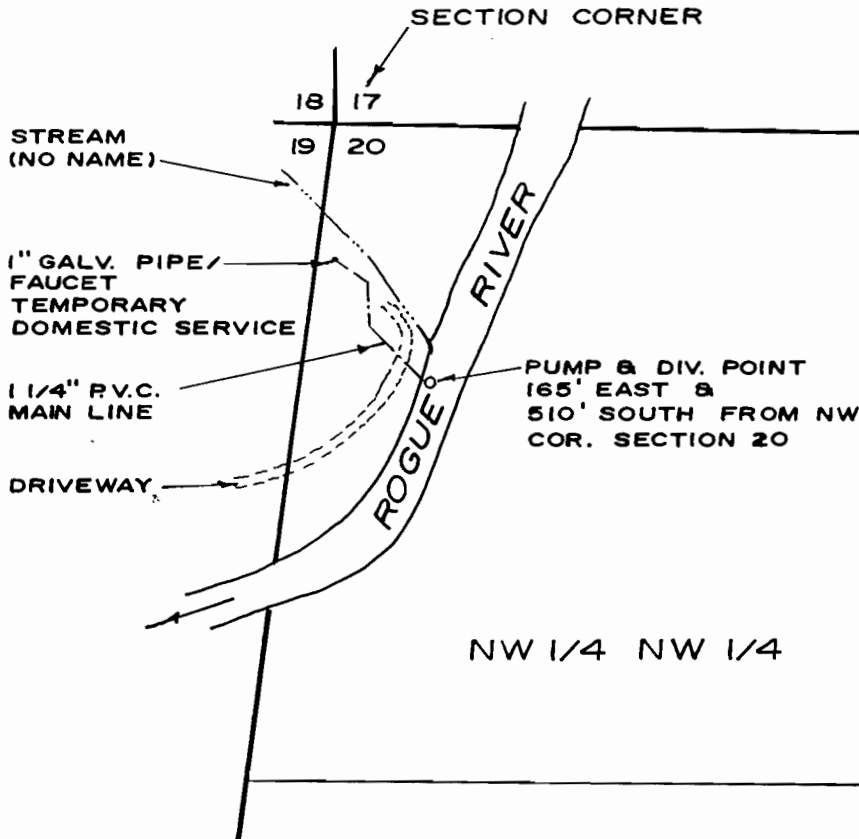


T.32S.,R.3E.,W.M.

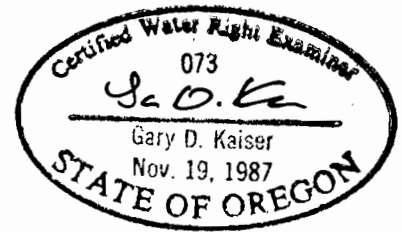

SCALE: 1" = 400'

FINAL PROOF MAP

NOTE THIS MAP HAS BEEN PREPARED FOR WATER RIGHT PURPOSES ONLY, NOT FOR PROPERTY BOUNDARY LOCATION

APPLICATION No. 69429 PERMIT No. 50216

IN THE NAME OF

OWEN L. & MARYLYN R. GOSSETT

MAP PREPARED SEPTEMBER 16, 1991 BY GARY D. KAISER