


67965  
53552  
L7300

# T. 4 N., R. 30 E., W. M.

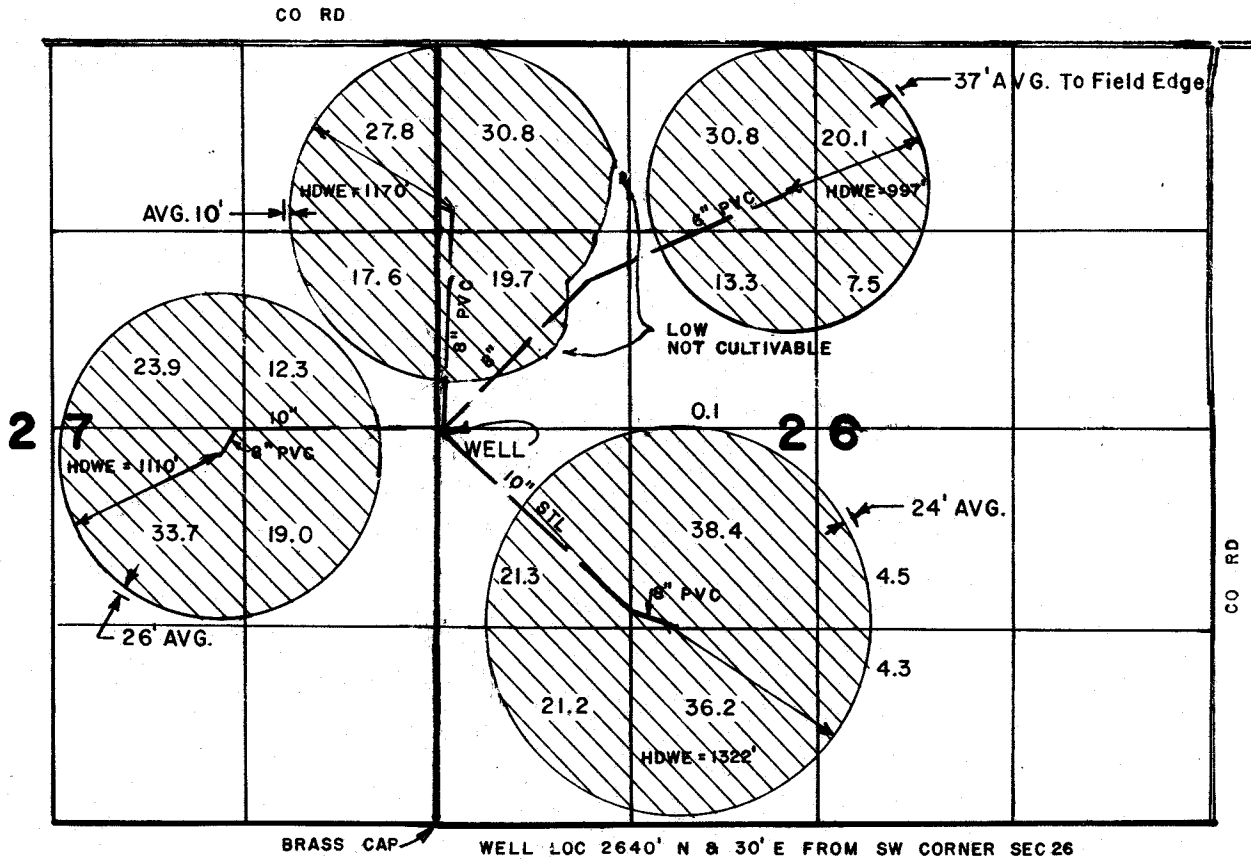

SCALE 1" = 1320'

## FINAL PROOF SURVEY UNDER

T-5936  
 Application No. T-6290 Permit No. G-7965  
 IN NAME OF  
RONALD M. KILGORE

Surveyed 7/10 1989, by W. N. REYNOLDS  
8 4/9/90

