


T. 17 S., R. 2 W., W.M.

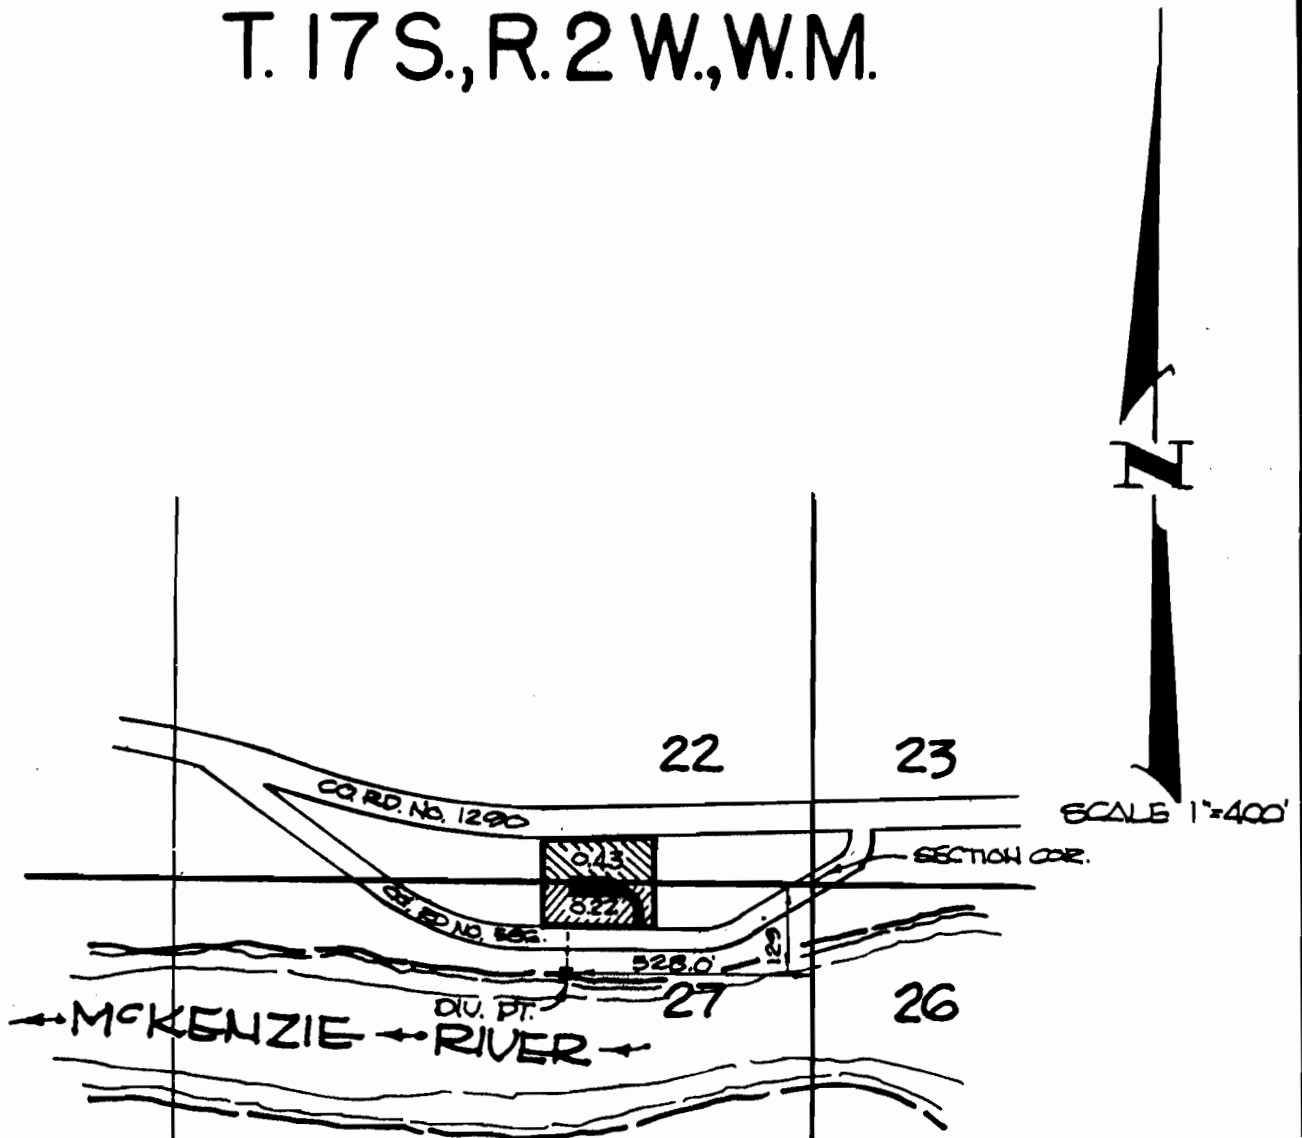

THIS DOES NOT CONSTITUTE A BOUNDARY SURVEY
AND IS SUBJECT TO ANY INACCURACIES THAT A
SUBSEQUENT BOUNDARY SURVEY MAY DISCLOSE,



FINAL PROOF SURVEY
UNDER

APPLICATION NO. 70219 PERMIT NO. 50988
IN NAME OF

GUY M. AND DARLENE K. BUTTERFIELD

SURVEYED FEBRUARY 14, 1991 BY