


# T.28S.R.14W.W.M.

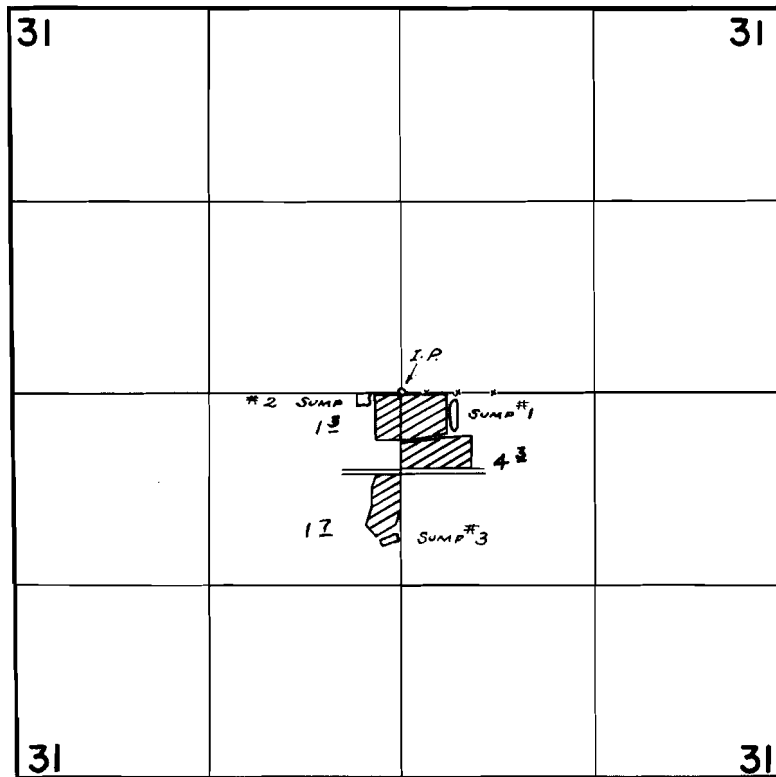

Sumps Located: 360'E of 150'S All From Cen. Sec.31  
260'W of 40'S  
80'W of 1020'S

## FINAL PROOF SURVEY UNDER

Application No. G-2987 Permit No. G-2778  
IN NAME OF

GROVER HAGA & JEAN HAGA

Surveyed MAY 16 1969, by W. RUPPERT