


T-5683

T. 30 S. R. 5 W. W. M.

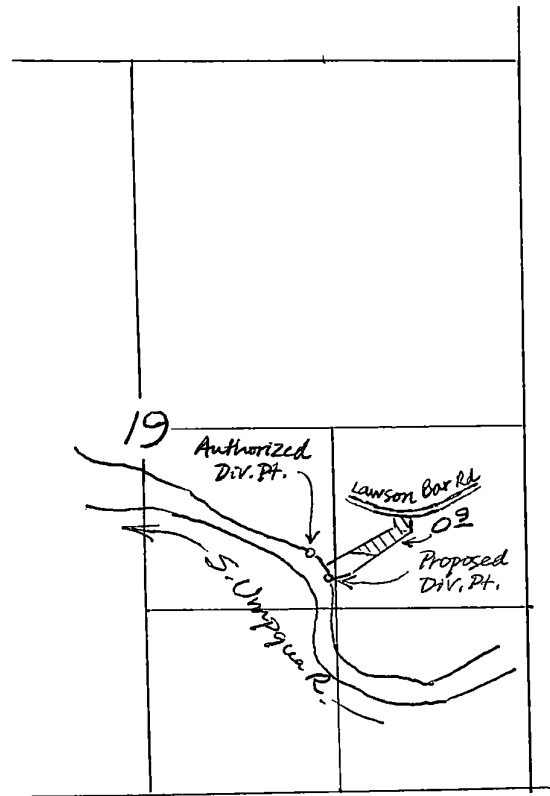

Scale : 4" = 1 mile

Proposed Div. Pt : 1550' N & 1320' E
from the S $\frac{1}{4}$ Cor. Sec. 19.