


T.17S., R.23E., W.M.

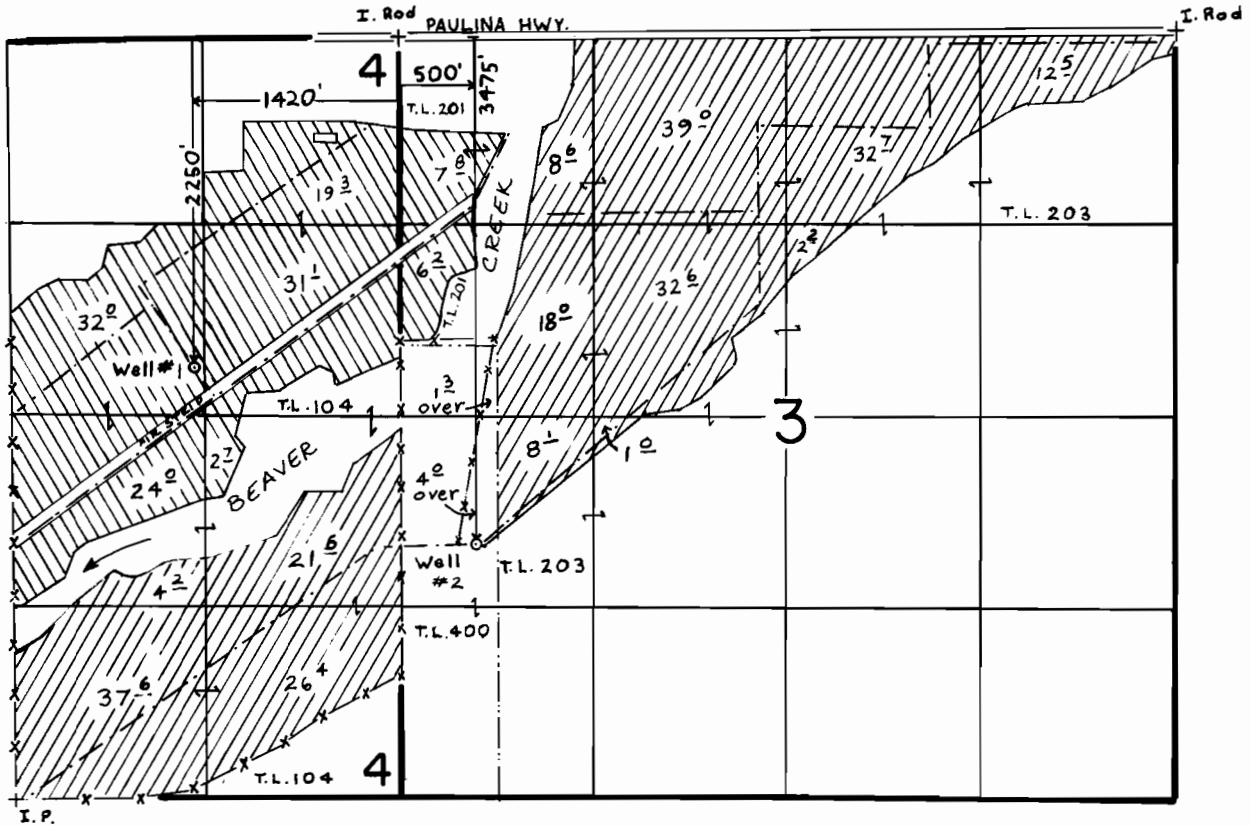

SCALE : 1" = 1320'

FINAL PROOF SURVEY

UNDER

G-9753

G-9255



Application No. ~~G-9754~~ Permit No. G-9256



IN NAME OF

.....PAULINA RANCHES, INC.....

Surveyed JULY 15, 1986, by LESLIE OLSON
& AUG. 25