


T. 4N., R. 28E., W.M.

S1607  
L1850  
L7326

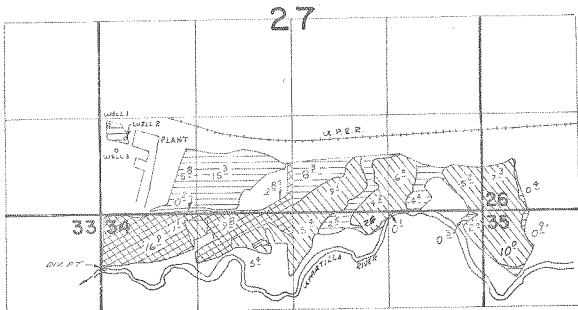

DIVERSION POINT LOCATED 150' S. & 50' E. FROM NW COR SEC. 34.  
WELL 1 LOCATED 1230' N. & 130' E. FROM SW COR SEC. 27.  
WELL 2 LOCATED 1030' N. & 360' E. FROM SW COR SEC. 27.  
WELL 3 LOCATED 880' N. & 230' E. FROM SW COR SEC. 27.



PER 37853 PRIMARY



PER G-7077 PRIMARY



PER G-7077 SUPPLEMENTAL

### FINAL PROOF SURVEY

UNDER

TRANSFER 3036

50554

37853

Application No. G-7168 Permit No. G-7077

IN NAME OF

J. R. SIMPLOT CO.

Surveyed 8-11-1978, by R. BARWIN  
10-24-1978 R. Barwin  
9-27-1979 U. Church

R3-12  
N2-1114-138 V.L.C.