


T.27S.R.15E.W.M.

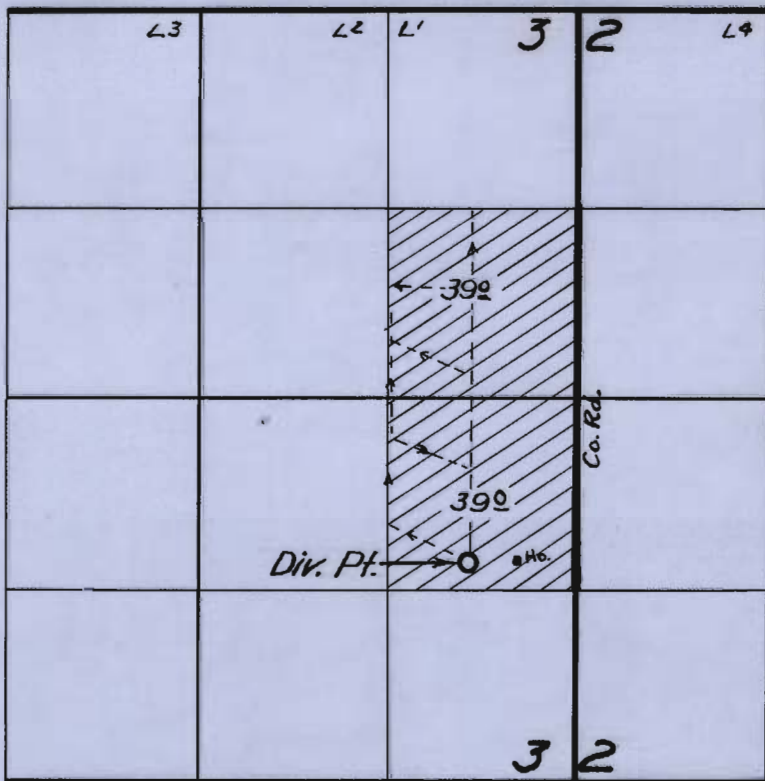

**FINAL PROOF SURVEY**  
UNDER

Application No. U-347 Permit No. U-322  
IN NAME OF

Leonard Pitcher

Surveyed June 20 1955, by T. Jones

CHZ-45K-115