




T. 35 S., R. 5 W., W.M.

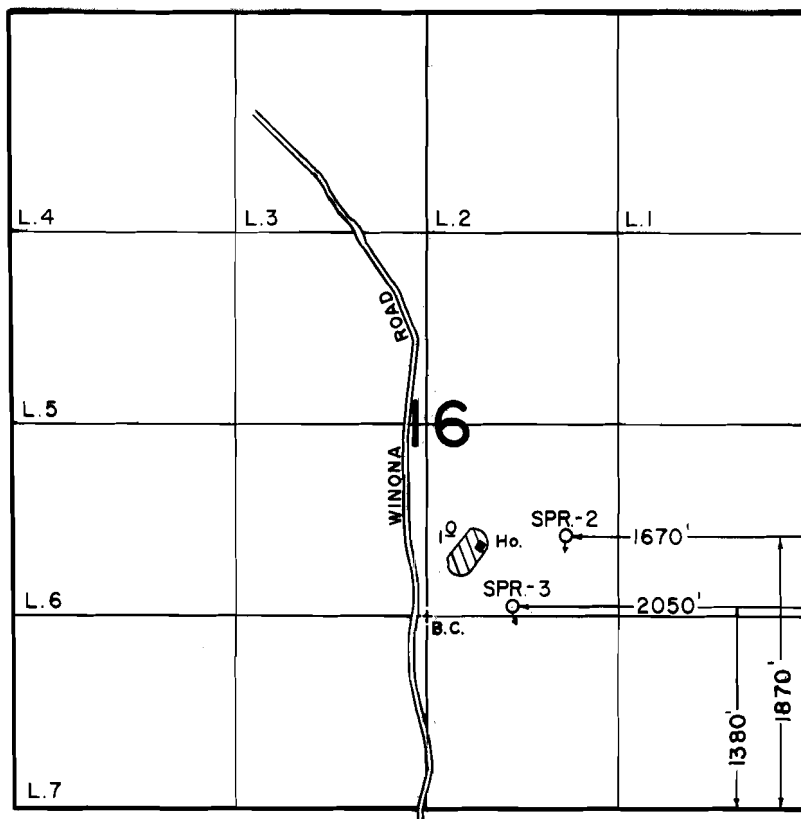

SCALE: 1" = 1320'

FINAL PROOF SURVEY
UNDER

Application No. 56797.. Permit No. 42590....
IN NAME OF

EVERGREEN FEDERAL SAVING & LOAN

Surveyed MAY 25.. 1989, by B.S. JAMES.....