


T.36 S., R.2 E., W. M.

FINAL PROOF SURVEY
UNDER
R-45630 R-5395
45631 34033
Application No. 41718 Permit No. 31146
IN NAME OF
C-2 CATTLE CO.
Surveyed June 27, 1989 by B. S. James

SCALE 1"=1320'

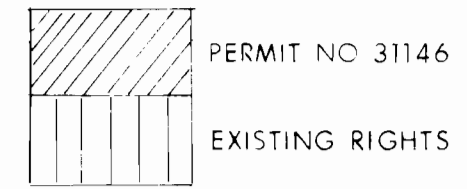

DIVERSION POINTS LOCATED - North Hanley Canal 1498' N & 420' W,
South Hanley Canal 409' N & 265' E, Both From The SW Corner Of
Section 25 Reservoir- 700' S. & 350' E. From The N 1/4 Corner Of Sec. 26

Photos 41029-279-172R, 133L, 132L & 132R

6-4-90 DLM

