


T.36 S., R. 2 E., W. M.

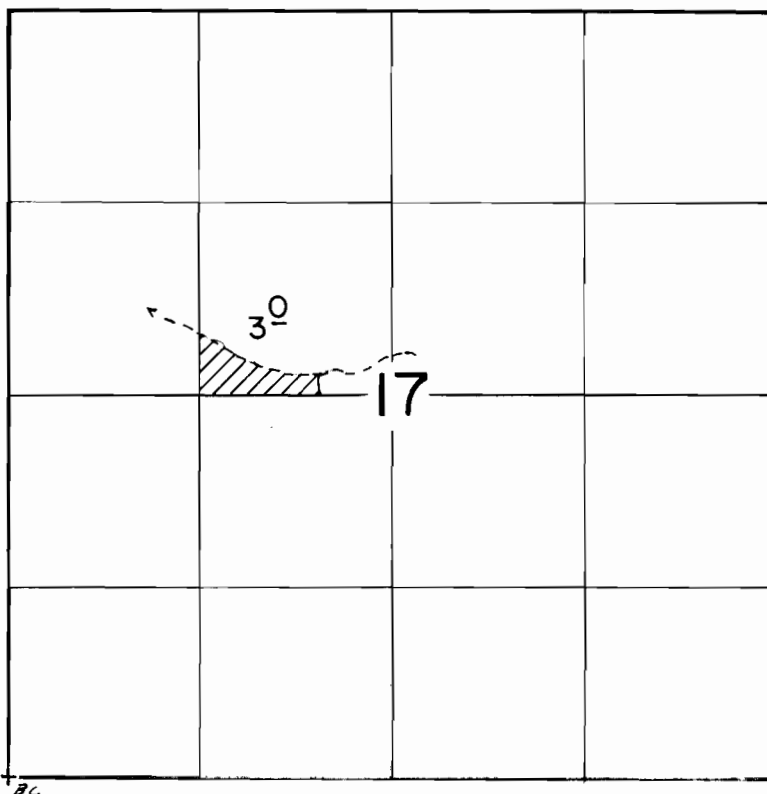

Scale 1"=1320'

FINAL PROOF SURVEY

UNDER

Transfer No. 2420

Application No. Permit No.
IN NAME OF

.....C-2.....CATTLE.....CO.....

Surveyed June 27, 1989, by B.S. JAMES.....