


T.36 S., R.2 E., W.M.

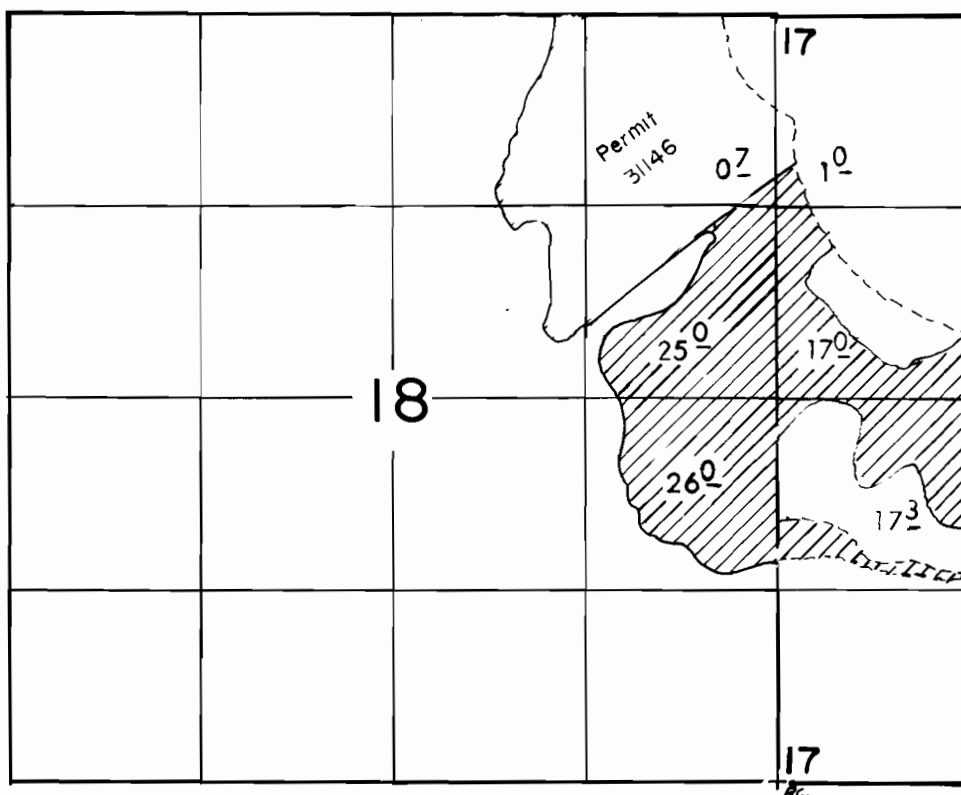

Scale 1"=1320'

FINAL PROOF SURVEY
UNDER

Transfer No. 2418

Application No. Permit No.
IN NAME OF

..... C-2 CATTLE CO.

Surveyed June 27, 1989, by B.S. JAMES