


T. 36 S., R. 2 E., W. M.

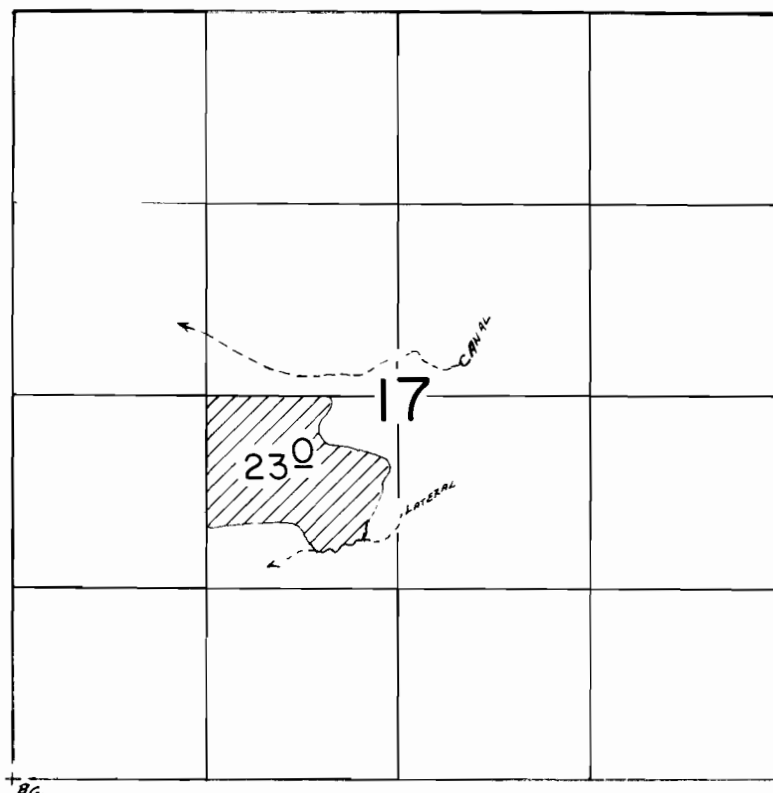

Scale 1" = 1320'

FINAL PROOF SURVEY UNDER

Transfer No. 2416

Application No. Permit No.

IN NAME OF

..... C-2 CATTLE CO.

Surveyed June 27, 1989, by B.S. JAMES