


T.36 S., R.2 E., W. M.

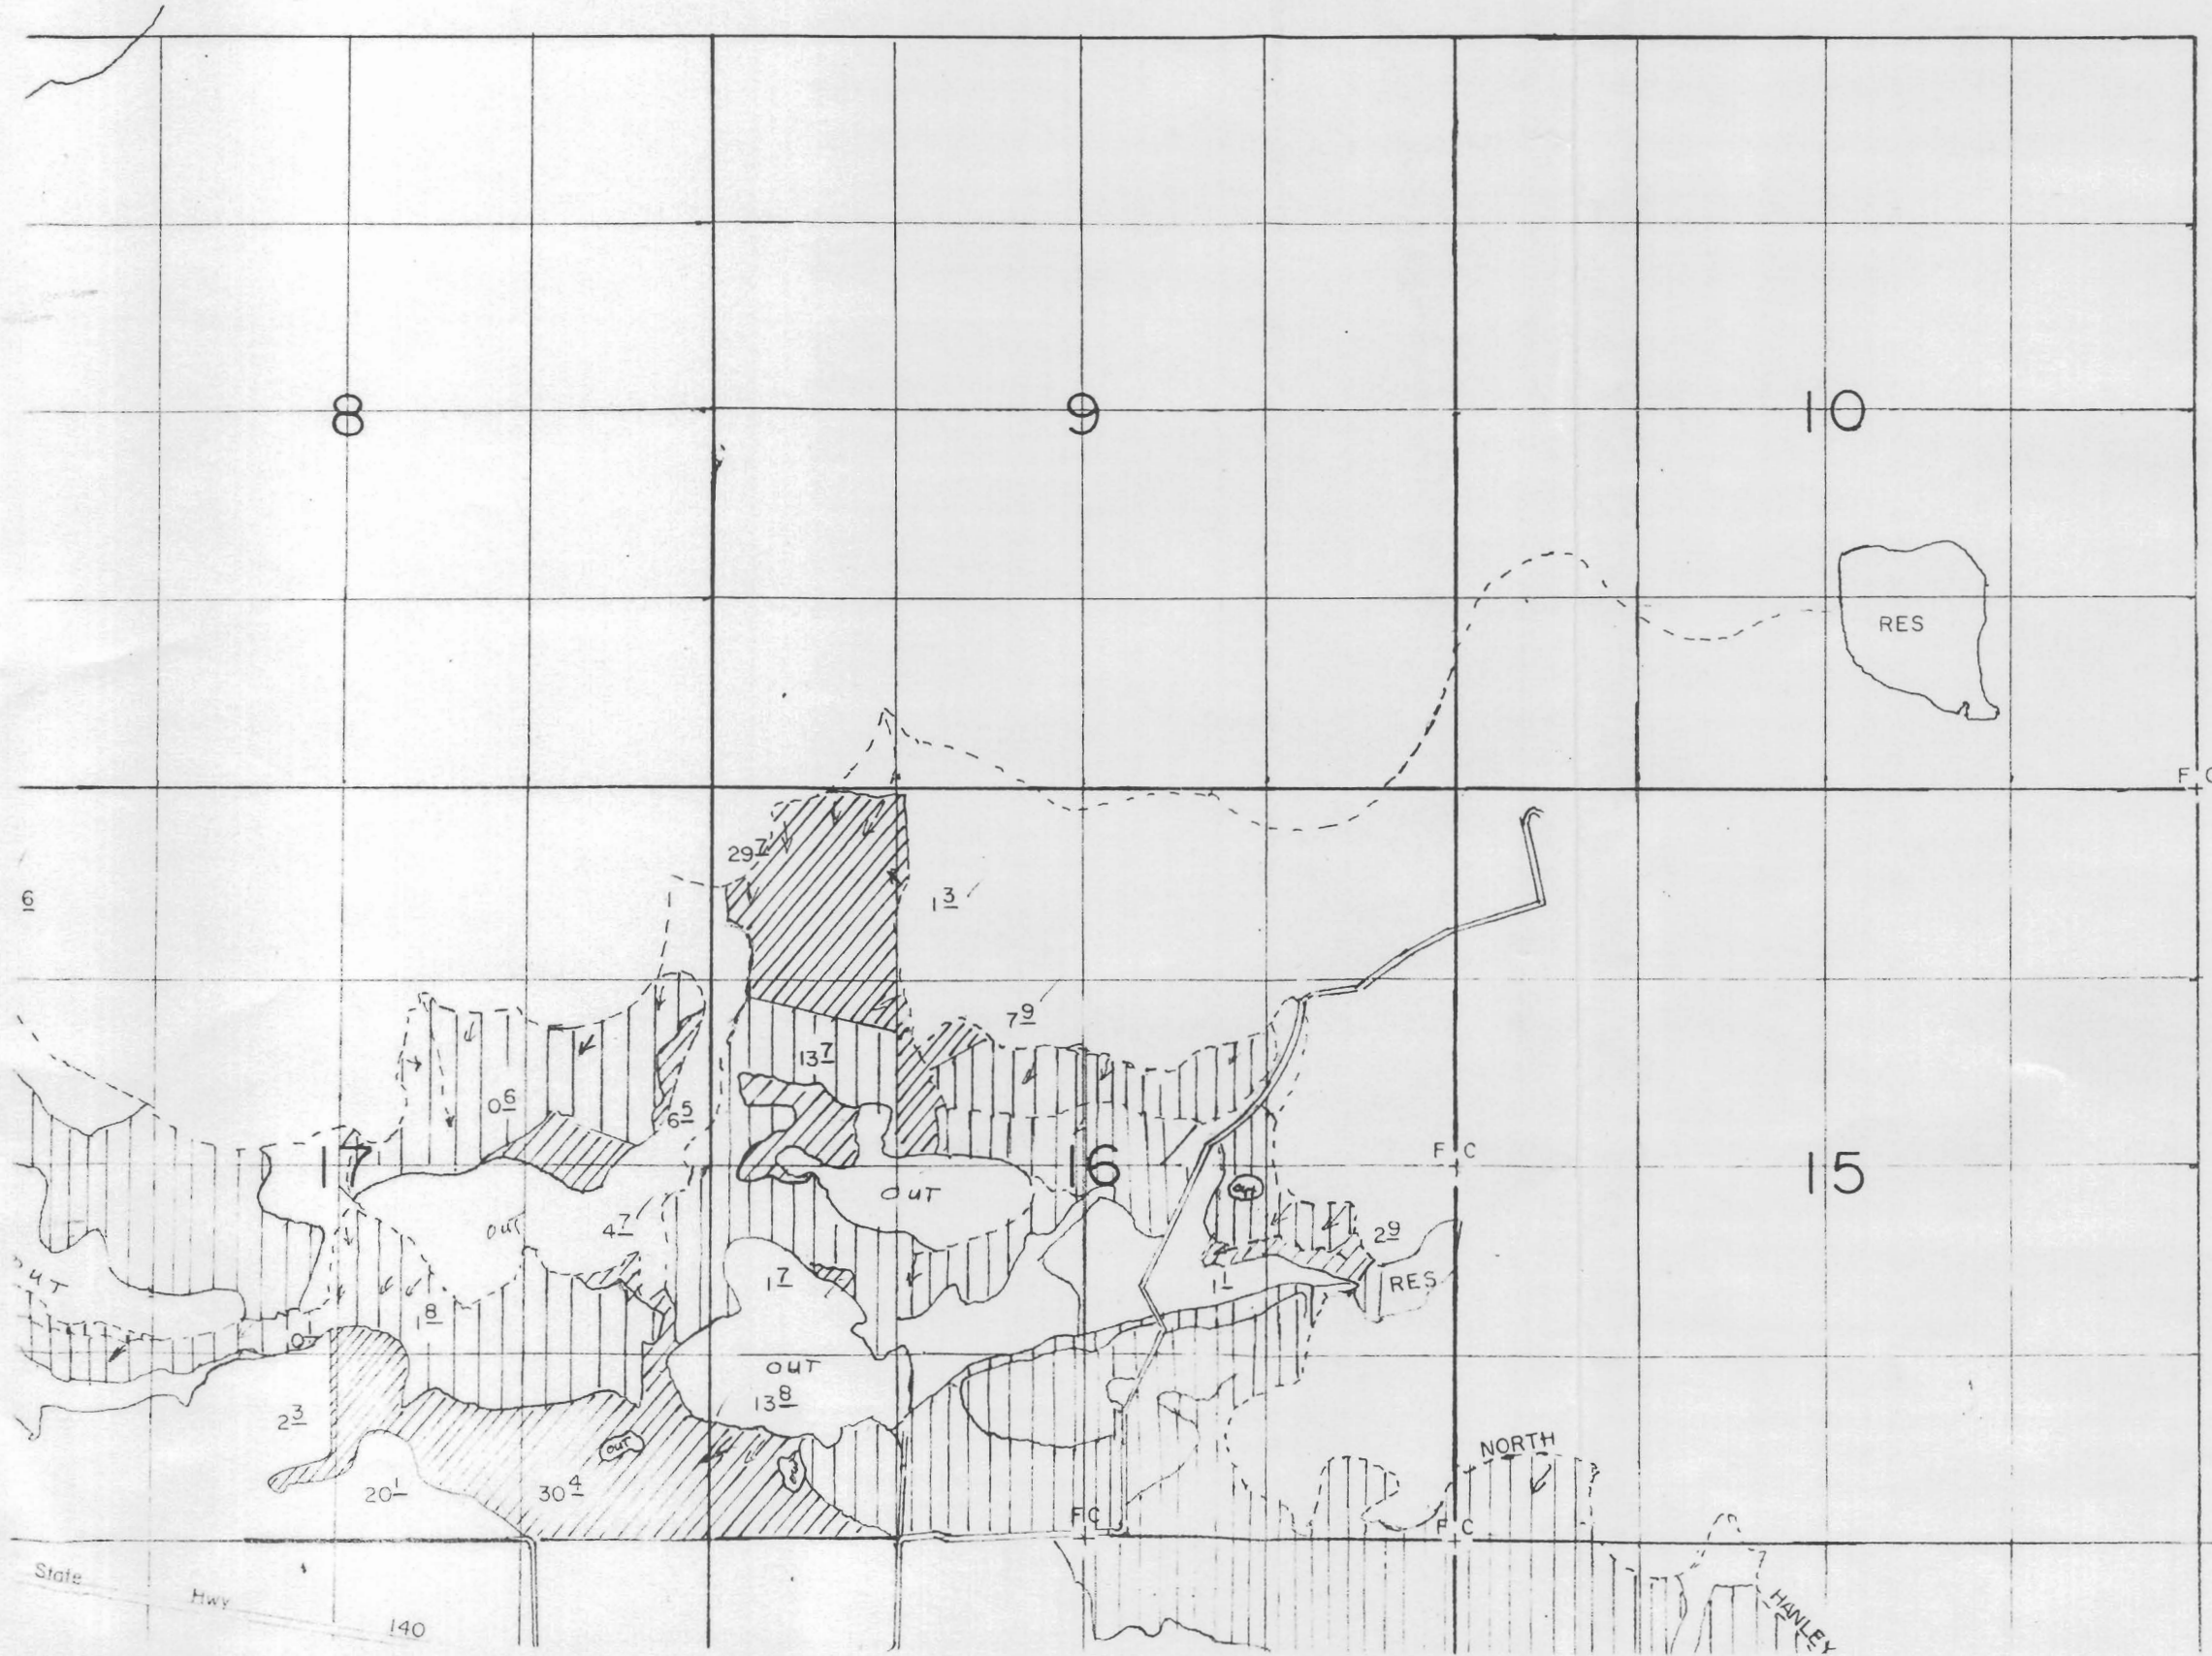

FINAL PROOF SURVEY
UNDER

R-45630 R-5395
45631 34033


Application No. 41718 Permit No. 31146

IN NAME OF

C-2 CATTLE CO.

Surveyed June 27, 1989 by B. S. James

SCALE: 1"=1320'

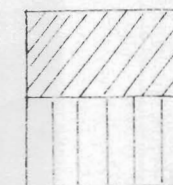

PERMIT NO 31146

EXISTING RIGHTS

DIVERSION POINTS LOCATED-North Hanley Canal 1496' N & 420' W,
South Hanley Canal 409' N & 265' E, Both From The S.W. Corner Of
Section 25 Reservoir-700' S & 350' E From The N/4 Corner Of Sec 26

Photos 41029-279-1 2R, 133L, 132L & 132R