T. 36 S. R. 2 E. W.M.

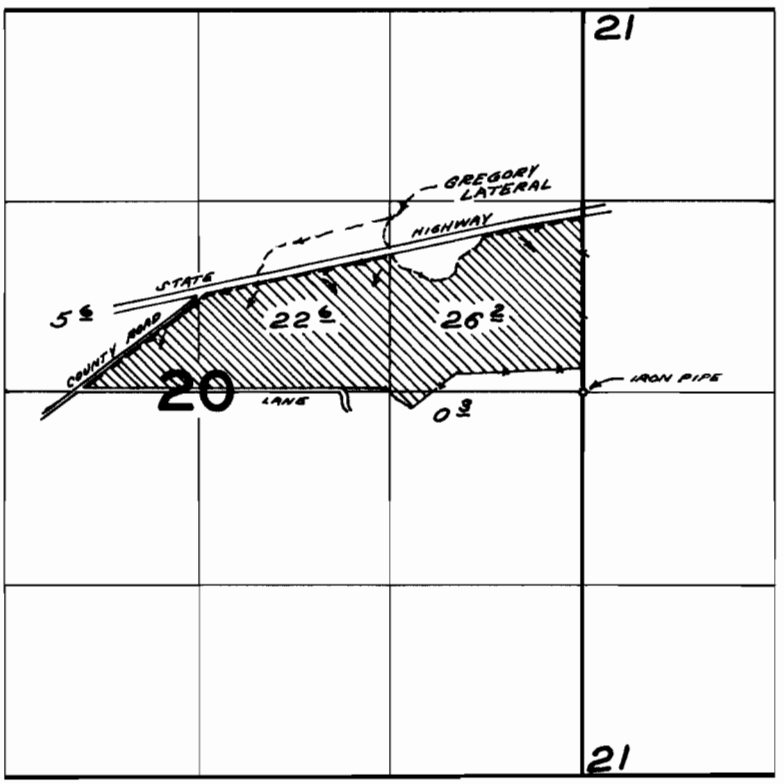

FINAL PROOF SURVEY
UNDER

TRANSFER No. C-172
Application No. ..... Permit No. .....
IN NAME OF

JAMES F. AND LURLINE R. COONAN

Surveyed JUN 10 1968, by V. GARNER

1968-B
DRB