


T.36S.,R.2E.,W.M.

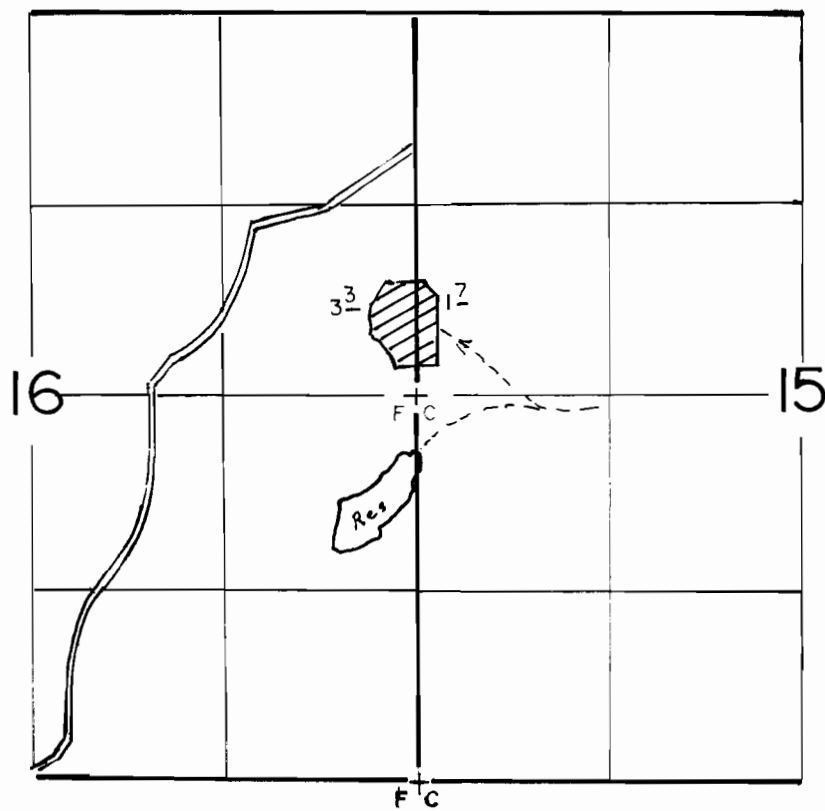

SCALE: 1"= 1320'

**FINAL PROOF SURVEY
UNDER**

TRANSFER NO. C-191

Application No. Permit No.
IN NAME OF

JAMES F. & LURLINE COONAN.....

Surveyed JUNE..7.. 1989., by B.S.JAMES.....