


T.2N.,R,1E.,W.M.

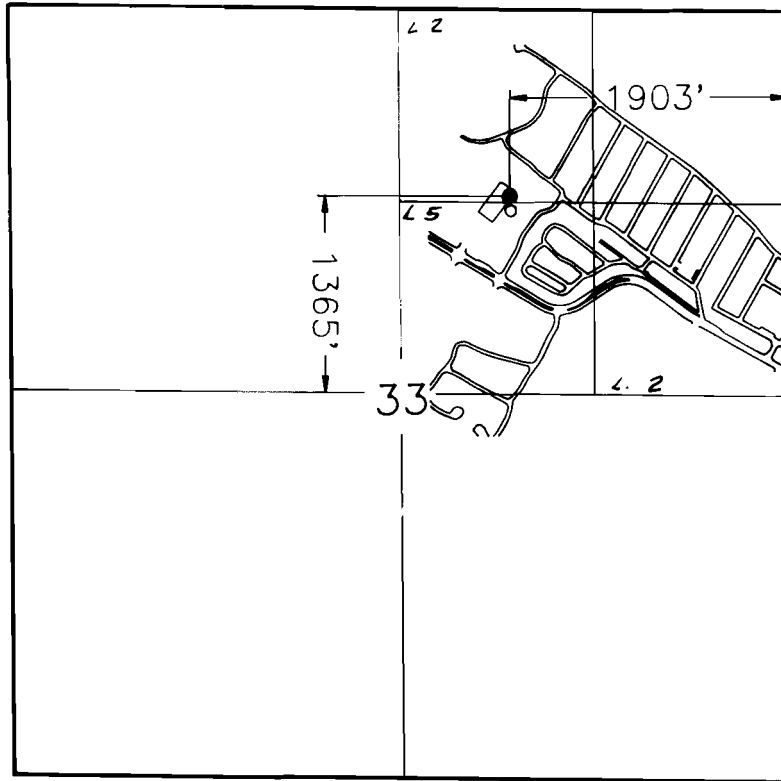

SCALE:
1" = 1320'

FINAL PROOF SURVEY
UNDER

Application No. G-5678 Permit No. G-5498

CITY OF PORTLAND, BUREAU OF WATER WORKS

Surveyed AUGUST 14, 1990

[Handwritten Signature]
9/10/90