


5285
6734

Sketch to accompany the application of James J. Kiely.

Sketch made from information furnished by the applicant.

7365-R25E.W.M.

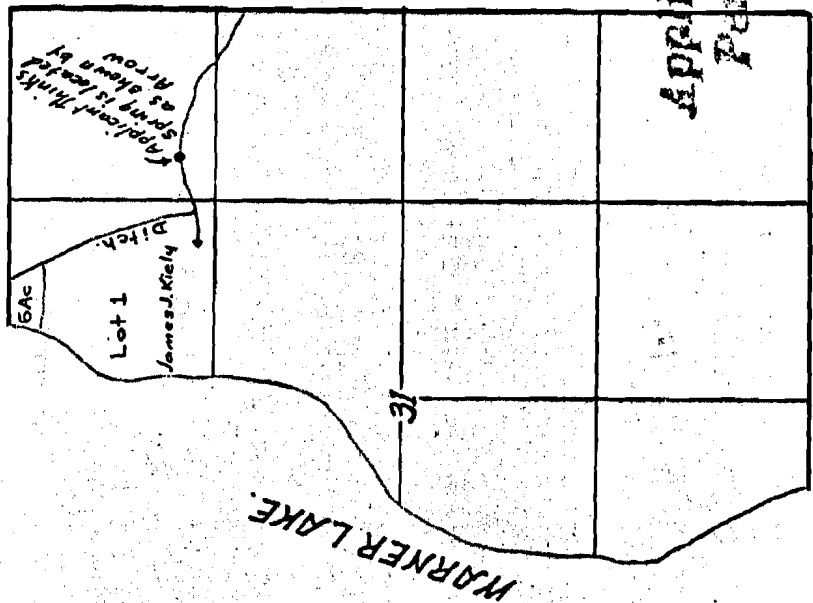

OFFICE OF STATE ENGINEER
 REGISTERED
 NOV 21 1921
 SALEM, OREGON

2174

Application No. 8174
 Permit No. 5285

4
7
7