


10/21/90

T.2N.,R,1E.,W.M.

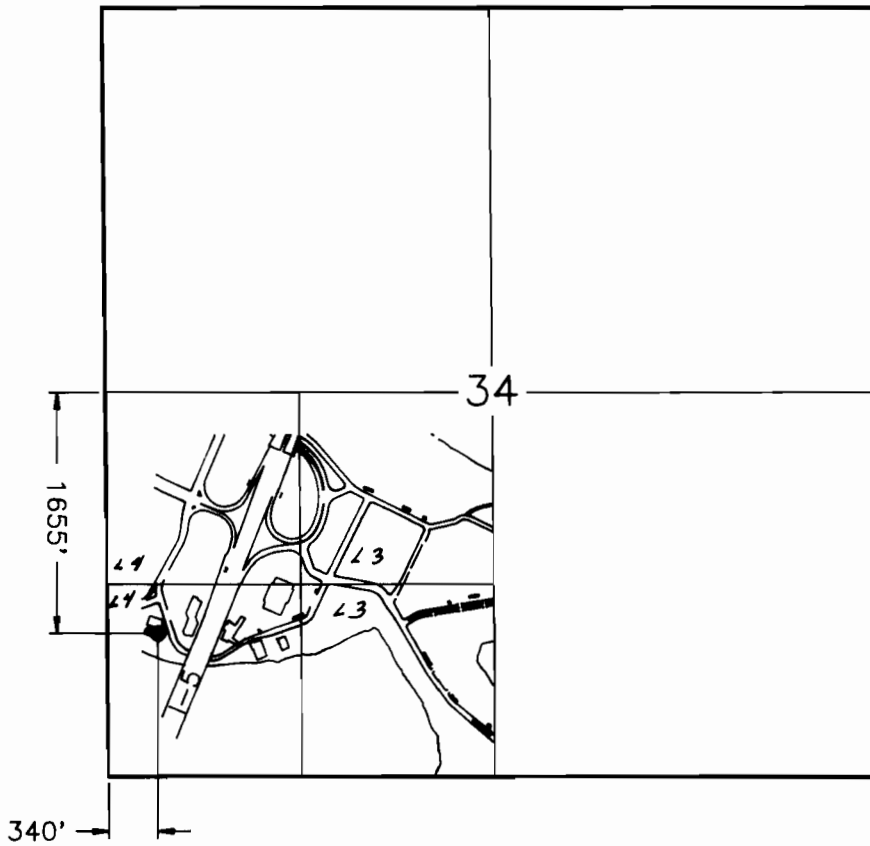

SCALE:
1" = 1320'

FINAL PROOF SURVEY UNDER

Application No.G-5967 Permit No.G-5659

CITY OF PORTLAND, BUREAU OF WATER WORKS

Surveyed AUGUST 14, 1990



9/10/90