
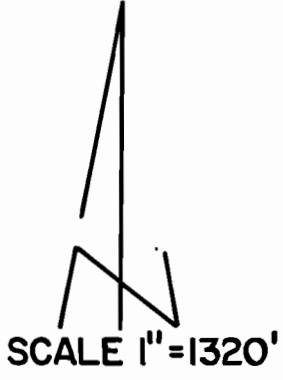


T. 25S., R. 33E., W.M.

DIRT ROAD

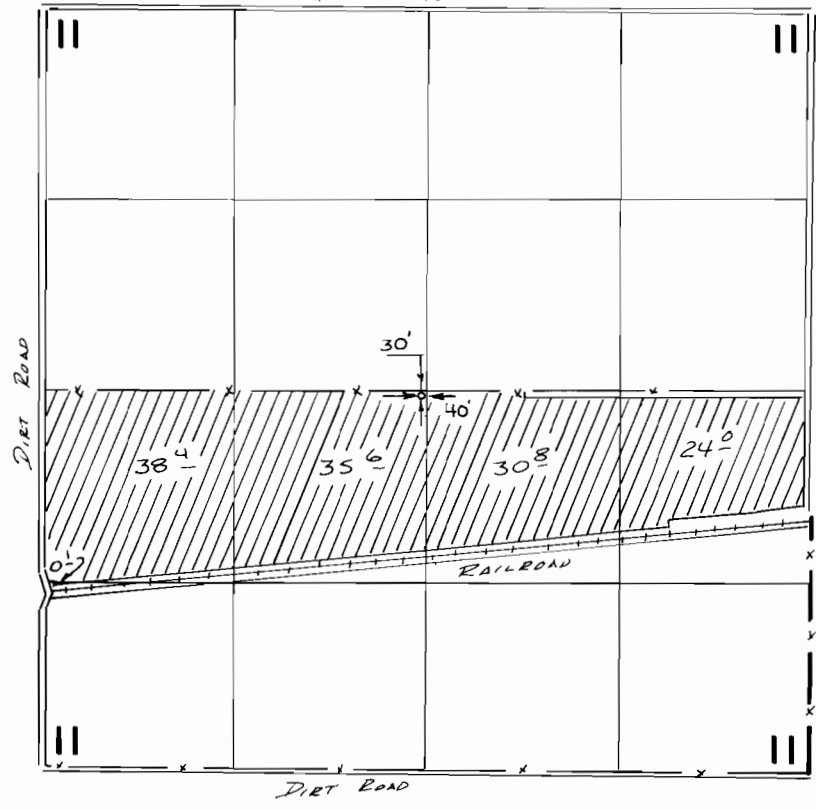

FINAL PROOF SURVEY UNDER

Application No. **G:8508** Permit No. **G:7835**...
IN NAME OF

.....**JOHN S. WILLIAMS**.....

Surveyed ..5..8..... 19**88**., by *W.H. Church*.....