


T. 8 S., R. 39 E., W.M.

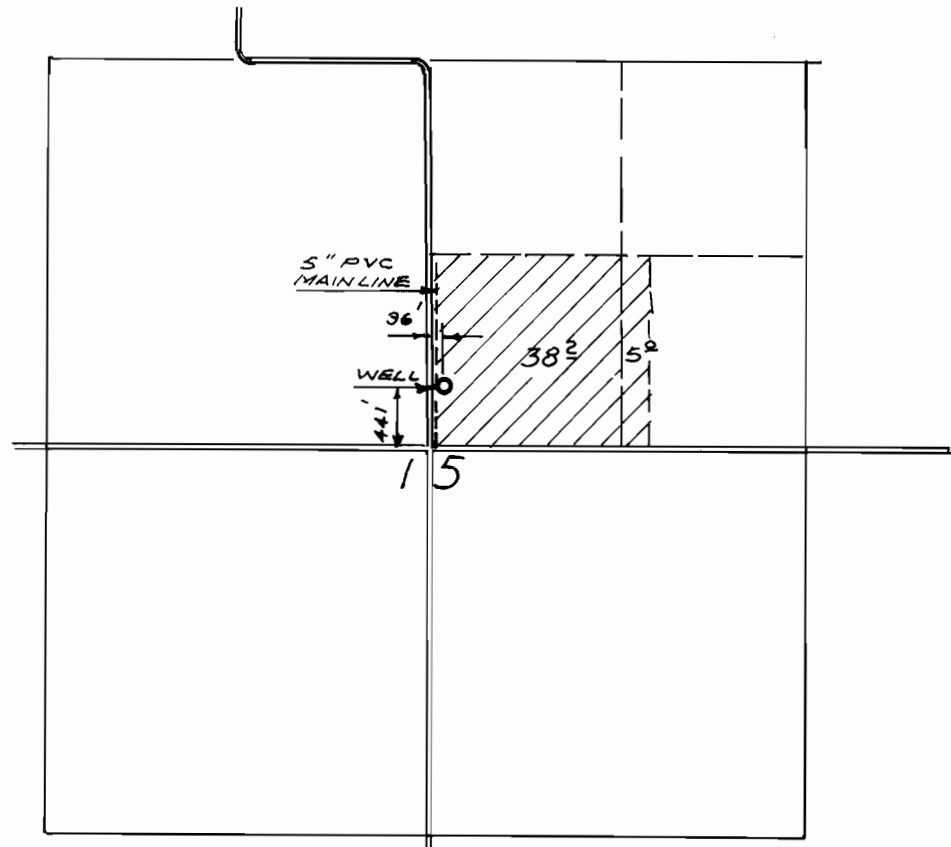

SCALE: 1" = 1320'

THE PURPOSE OF THIS MAP IS FOR IDENTIFYING THE LOCATION OF THE WATER RIGHT ONLY
AND IS NOT INTENDED TO PROVIDE LEGAL DIMENSIONS OF PROPERTY OWNERSHIP LINES.

FINAL PROOF SURVEY UNDER

Application No. G-11730 Permit No. G-10857

IN NAME OF

C.W. AND PHYLLIS JONES

Surveyed JULY 1, 1991

