


T. 40 S., R. 2 E., W. M.

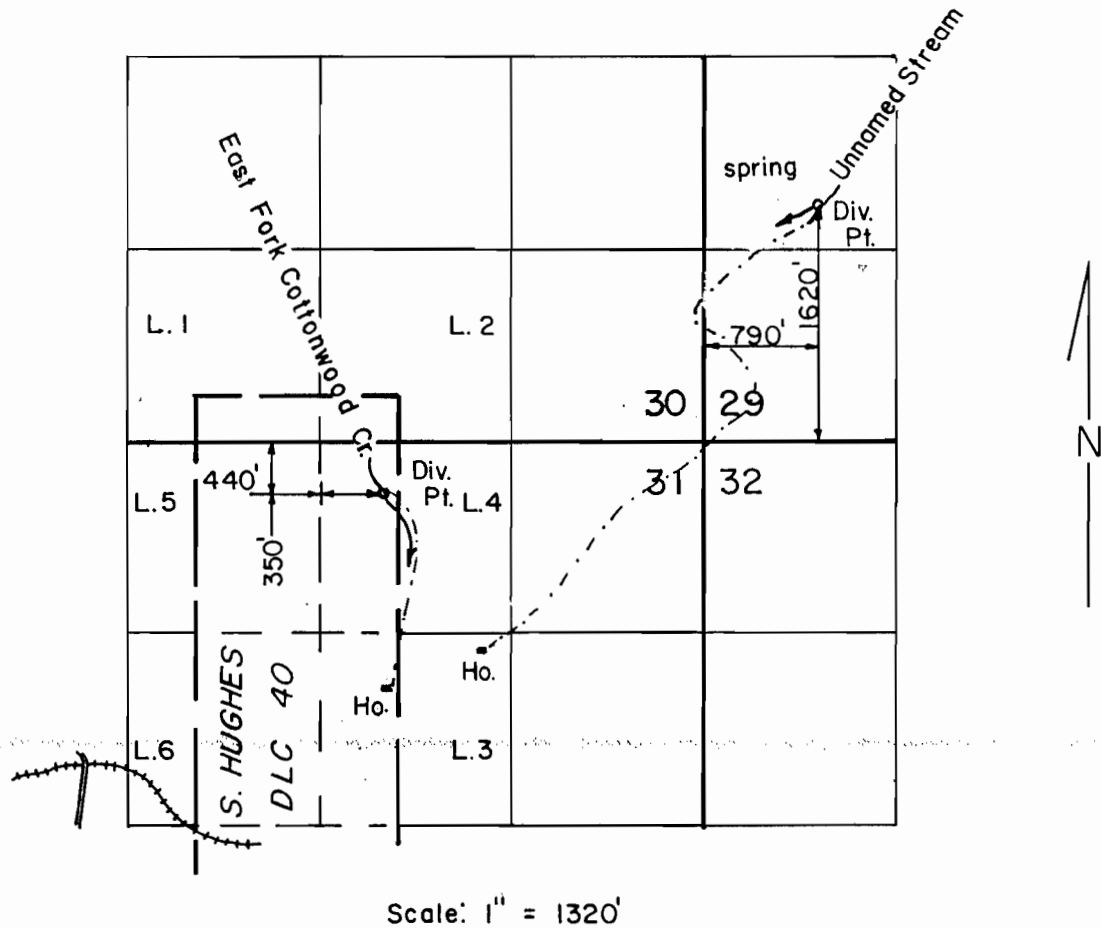

FINAL PROOF SURVEY
UNDER

60457 45657

Application No. 64960 Permit No. 47459...
IN NAME OF

.....YESHE.....NYNGPO, INC.....

Surveyed JULY 24 1991, by B. S. JAMES...