


T. 40 S., R. 2 E., W. M.

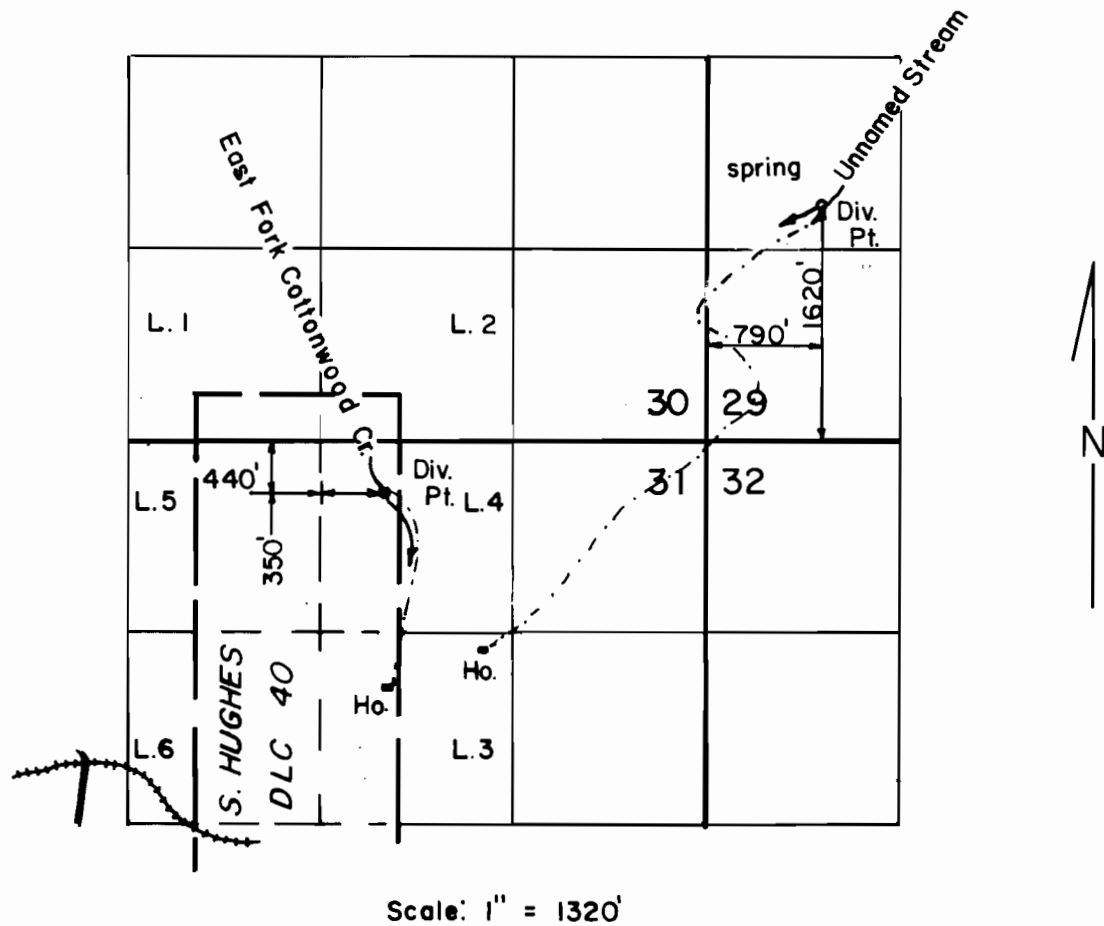

**FINAL PROOF SURVEY**  
**UNDER**

60457 45657

Application No. ~~64960~~ Permit No. ~~47459~~...  
IN NAME OF

.....YESHE.....NYNGPO,.....INC.....

Surveyed JULY 24 1991, by B. S. JAMES...