


T.39S.,R7E.,W.M.

SECTION 25

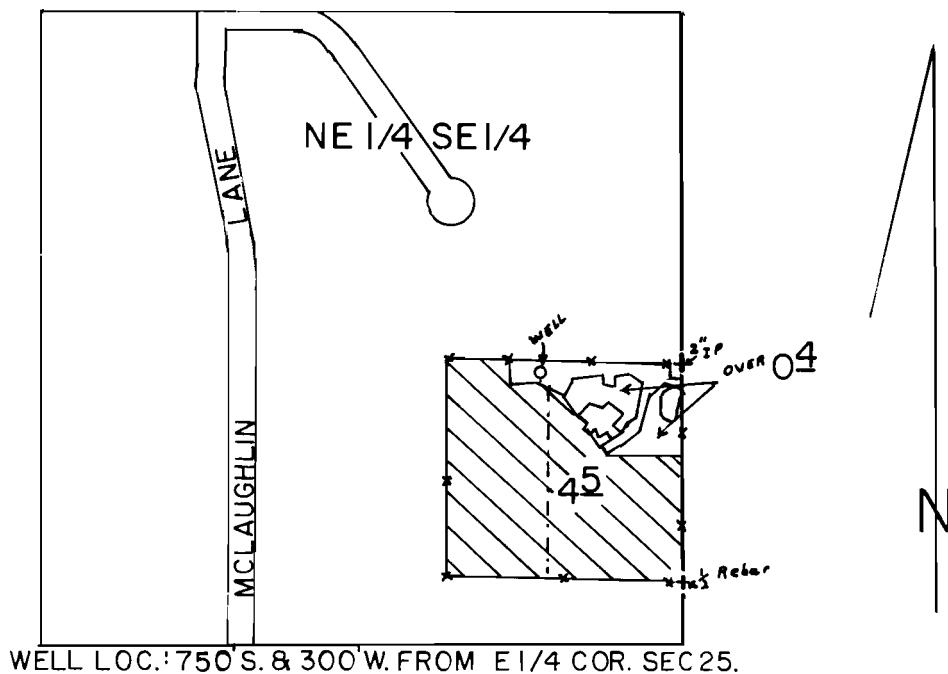

SCALE: 1" = 400'

**FINAL PROOF SURVEY**  
UNDER

Application No. G-11662 Permit No. G-10768  
IN NAME OF

DELBERT & NORANNE SPARKS...

Surveyed APR...18 1991... by B.W. BISHOP...