


T. 24 S., R. 12 W. W.M.

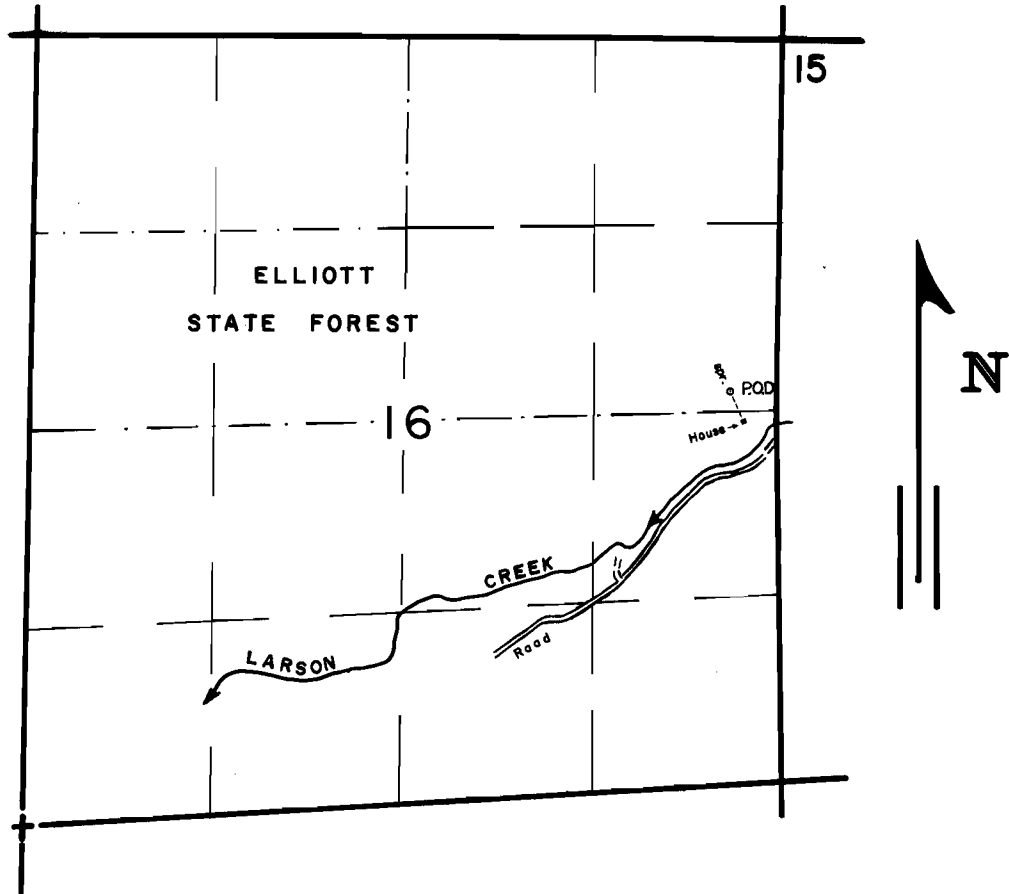

SCALE: 1" = 1320'

DIV. PT. LOCATED 190' N. & 330' W. from the E. $\frac{1}{4}$ cor. of sec. 16

FINAL PROOF SURVEY UNDER

Application No. 63386 Permit No. 46751.....
IN NAME OF

.....
Surveyed Sept. 17 1990, by J. Schmorde...