


T. 30S., R. 3 W., W. M.

SECTION 26

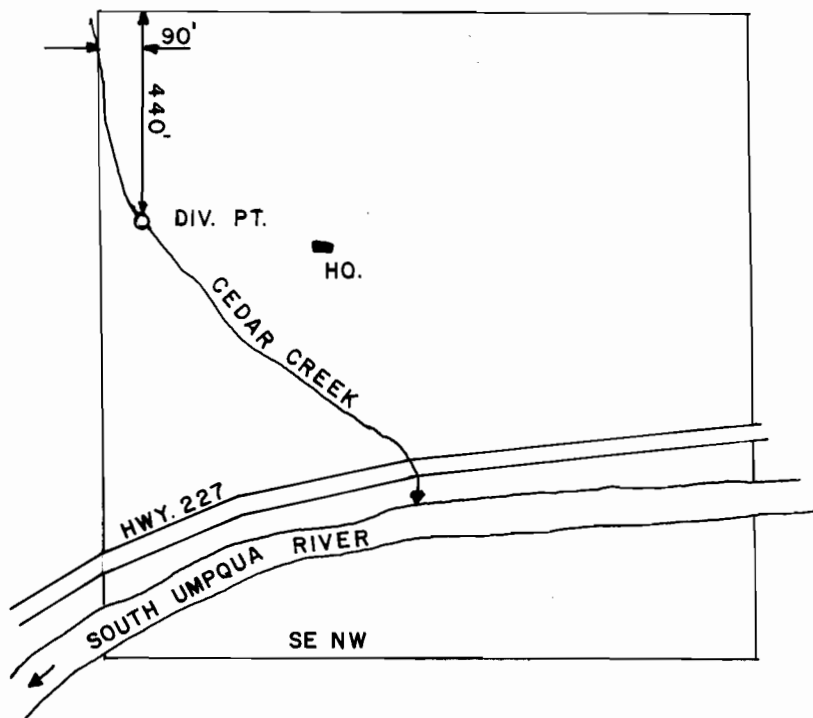

SCALE: 1" = 400'

**FINAL PROOF SURVEY**  
UNDER

Application No. 64801... Permit No. 47527.....  
IN NAME OF

**JAMES A. AND BETTY L. TIFFEE**

Surveyed JUNE 26, 1986., by J. M. SCHMORDE..