
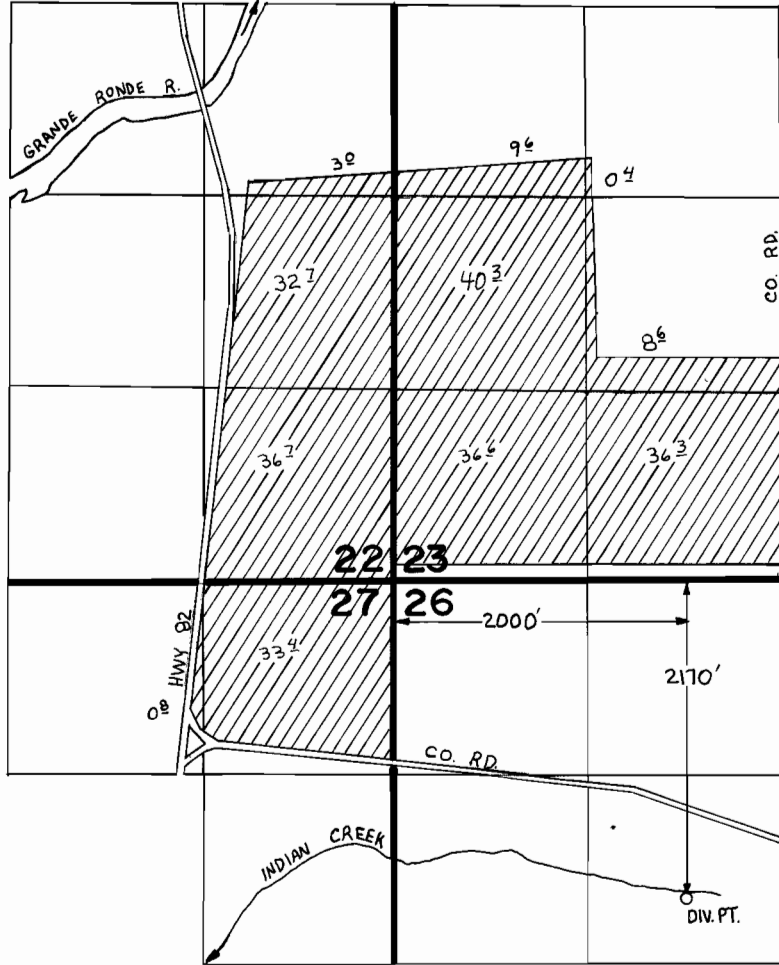


T. 1 N. R. 39 E. W.M.

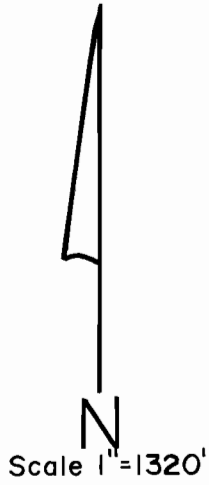

FINAL PROOF SURVEY UNDER

Application No. 58780. Permit No. 44616.....
IN NAME OF

.....**STEVEN J. GALLOWAY**.....

Surveyed May 22, 1986, by V. Church.....