

T 27 S., R. 13 W., W. M.

FINAL PROOF SURVEY  
UNDER

Application No. 69594 Permit No. 50448

IN NAME OF

IONA BLAKE

Surveyed Sept. 13, 1991



Scale: 1" = 200 ft.

15

10

14

11

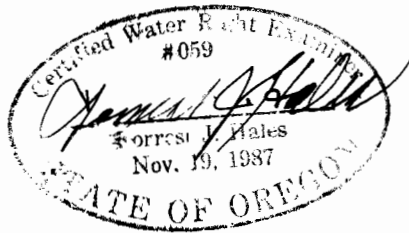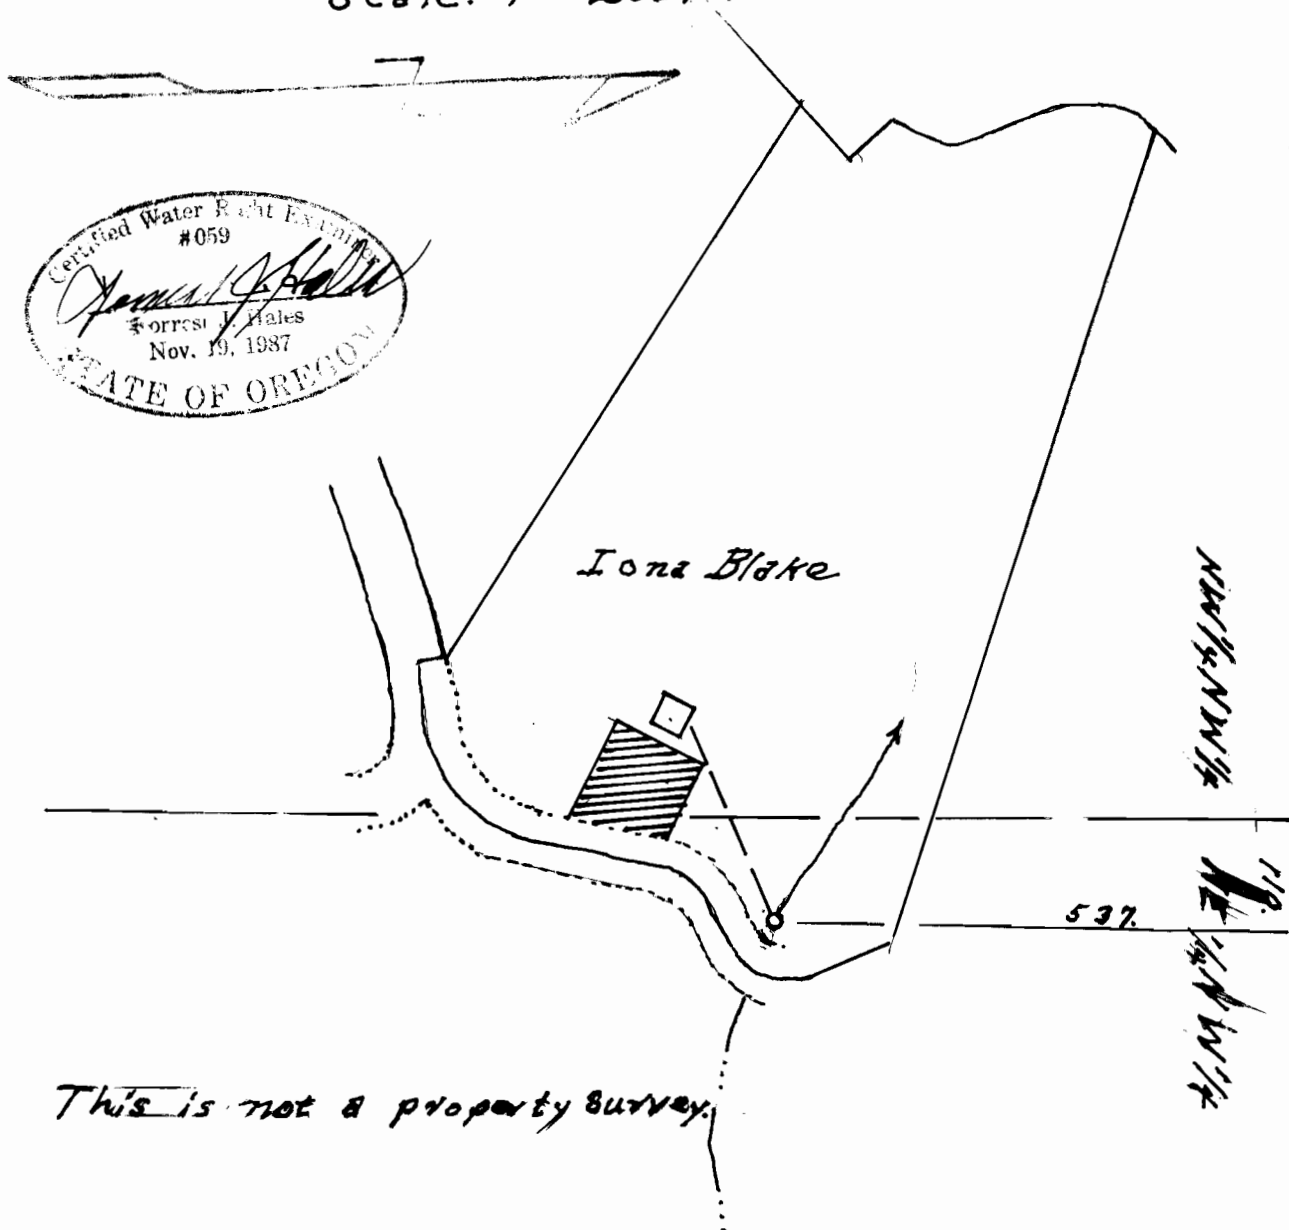

This is not a property survey.