


RECEIVED

T.6 S. R. 6 W. W.M.

MAY 1987
WATER DIVISION
SALEM, OREGON

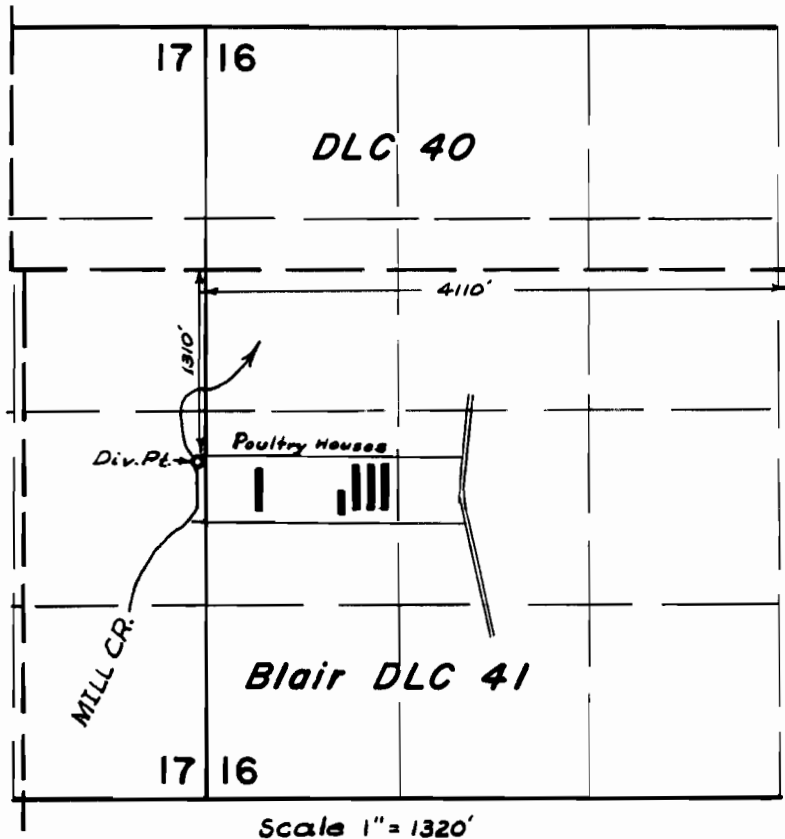

CLAIM OF BENEFICIAL USE
UNDER Transfer No. T-6239, APPLIC. No. 69889 &
PER. No. 50693
IN NAME OF
JERRY KEYES

THE PREPARATION OF THIS MAP IS FOR THE
 PURPOSE OF IDENTIFYING THE LOCATION
 OF THE WATER RIGHT ONLY AND HAS NO
 INTENT TO PROVIDE DIMENSIONS OR LOCATION
 OF PROPERTY OWNERSHIP LINES.

