


T.6S. R.6W.W.M.

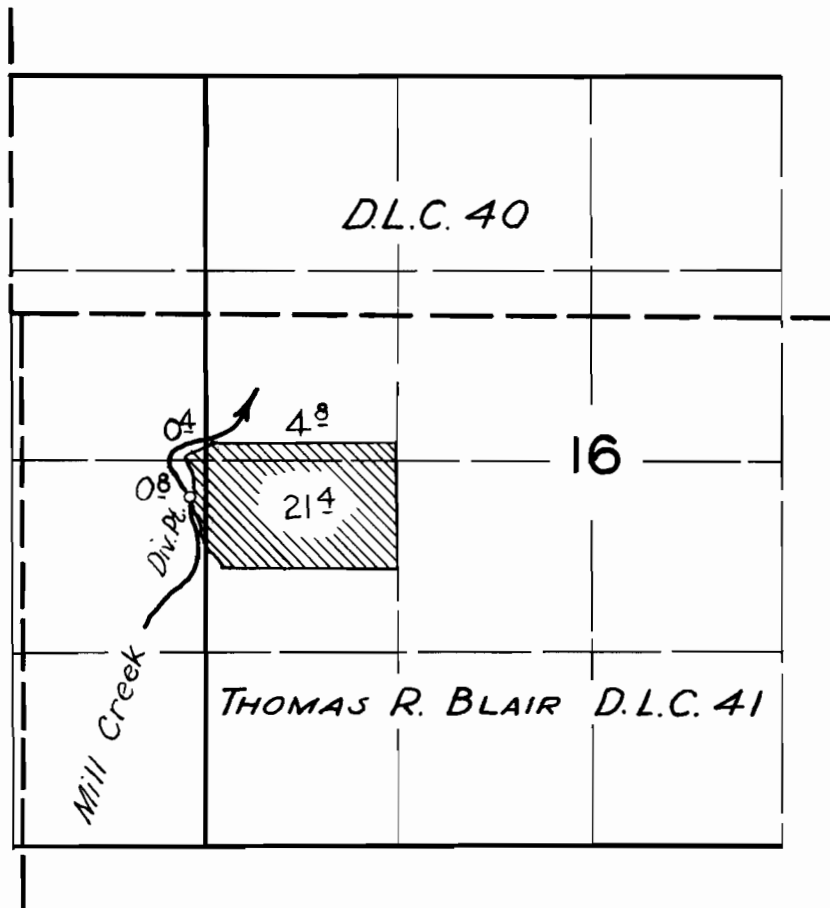

**FINAL PROOF SURVEY**  
UNDER

Application No. 22722 Permit No. 18028  
IN NAME OF

**DOYLE H. ALLBAUGH**

Surveyed April 7 1958, by R.H. Whitby.