


Township 4 South, Range 3 West


Portions of Sections 26, 27, 34 & 35

RECEIVED
 NOV 15 1991
 WATER RESOURCES DEP
 SALEM, OREGON

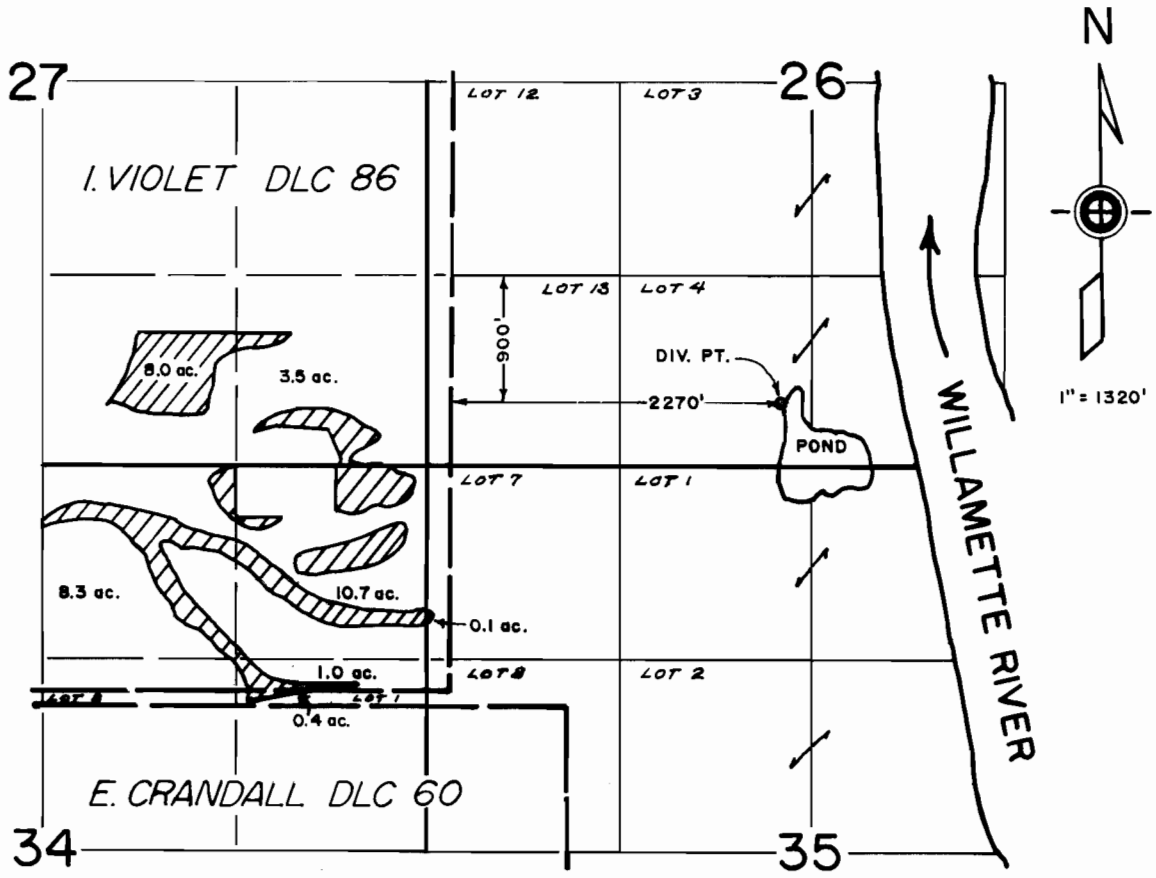

Appl. No. 70322
 Per. No. 51093

FINAL PROOF SURVEY
 in name of
WIL WILSON
 September 19, 1991

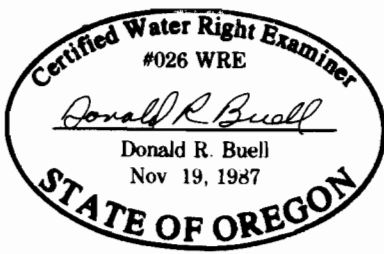

THIS MAP WAS PREPARED FOR THE PURPOSE OF IDENTIFYING THE LOCATION OF A WATER RIGHT ONLY AND IS NOT INTENDED TO PROVIDE LEGAL DIMENSIONS OR LOCATION OF PROPERTY OWNERSHIP LINES.