

RECEIVED

T.19 S., R.12 W.W.M.  
SECTION II


WATER RIGHTS  
SALEM, O.

PT.



SW1/4-NE1/4



SCALE 1"=400'

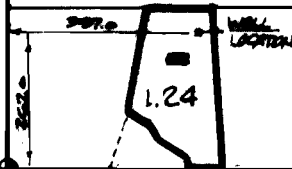

CENTER SEC. II

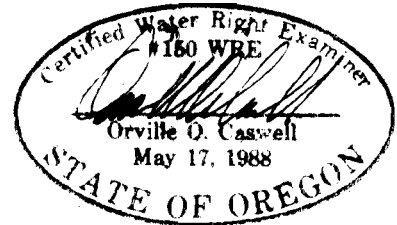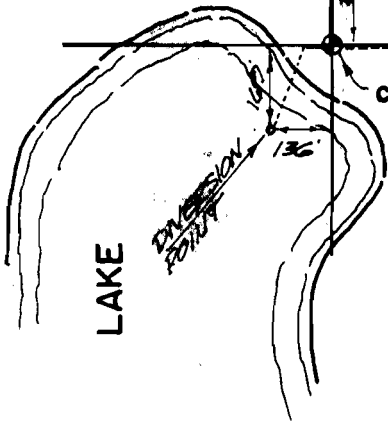

FINAL PROOF SURVEY

UNDER

APPLICATION NO. 70476 PERMIT NO. 51177

IN NAME OF

**B. T. BOOYE**

SURVEYED JANUARY 4, 1992 BY