


T. 26 S. R. 6 W. W. M.

SEC. 27

NW 1/4 SE 1/4

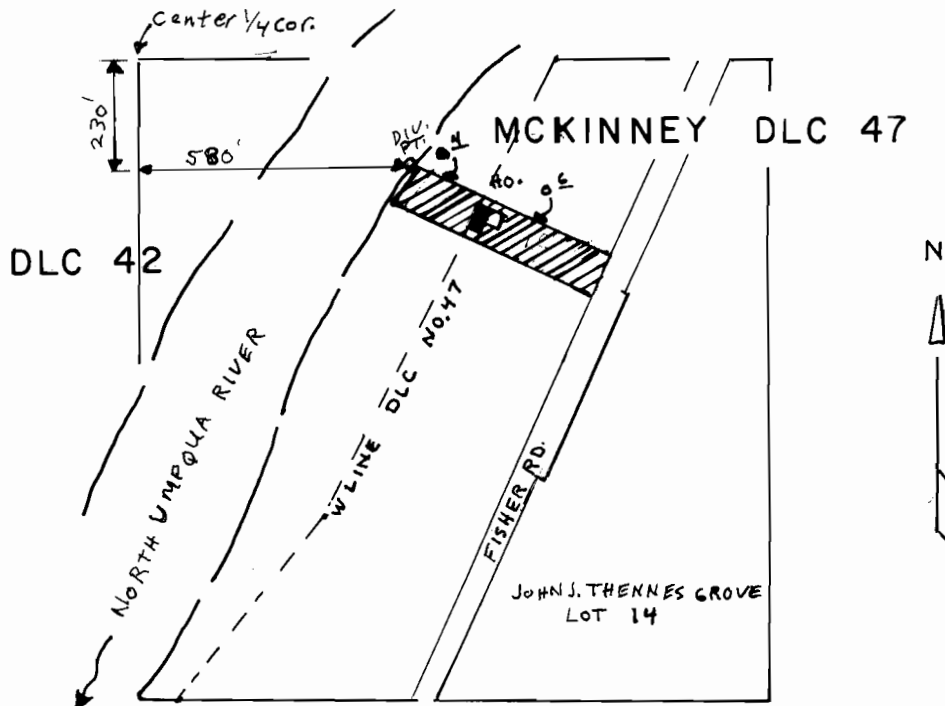

SCALE: 1" = 400'

FINAL PROOF SURVEY


UNDER

Application No. **70500** Permit No. **51074**

IN NAME OF

BOBBY V. TAYLOR

Surveyed Sept. 5, 1990 by D. KIRBY

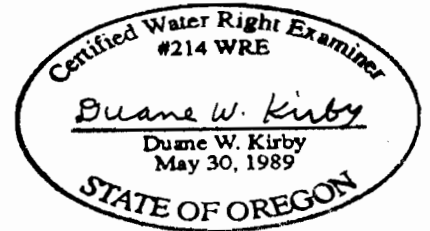

THE PURPOSE OF THIS MAP IS TO IDENTIFY THE LOCATION OF THE WATER RIGHT. IT IS NOT INTENDED TO PROVIDE INFORMATION RELATIVE TO THE LOCATION OF PROPERTY OWNERSHIP BOUNDARY LINES.