


T. 23S., R. 7W., W.M.

Cert 67371

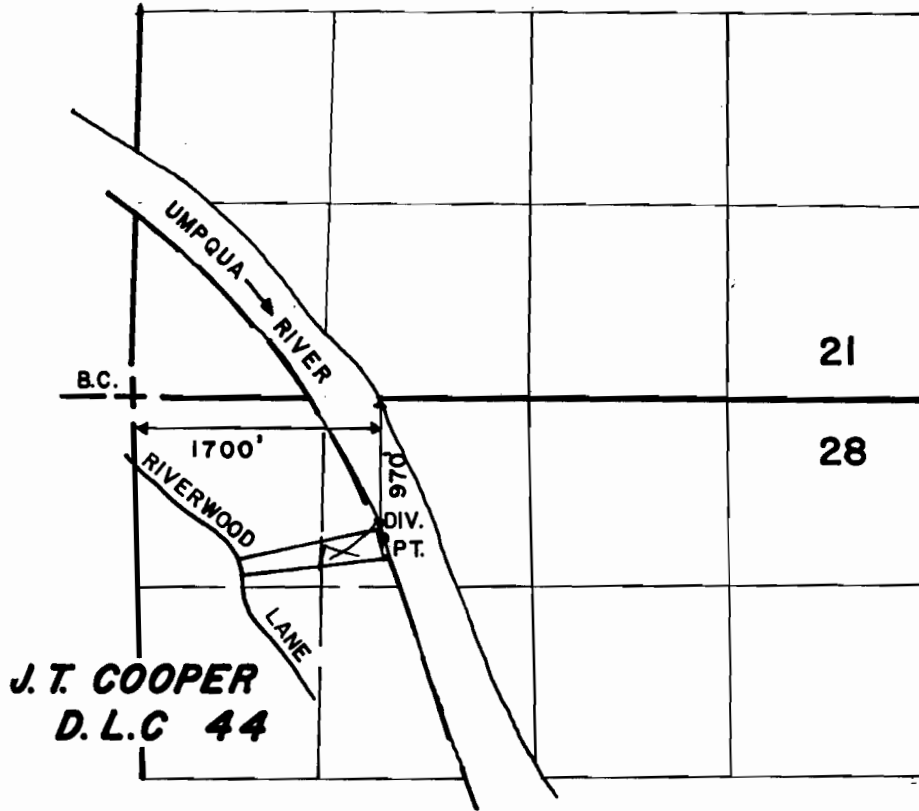

SCALE: 1" = 1320'

**FINAL PROOF SURVEY**  
UNDER

TRANSFER NO. 3726 OLD CERT. NO. 44464

IN NAME OF

**MICHAEL KILLIANY**

Surveyed AUG. 28 1986, by J. KAUPPILA