


T28S R14W WM

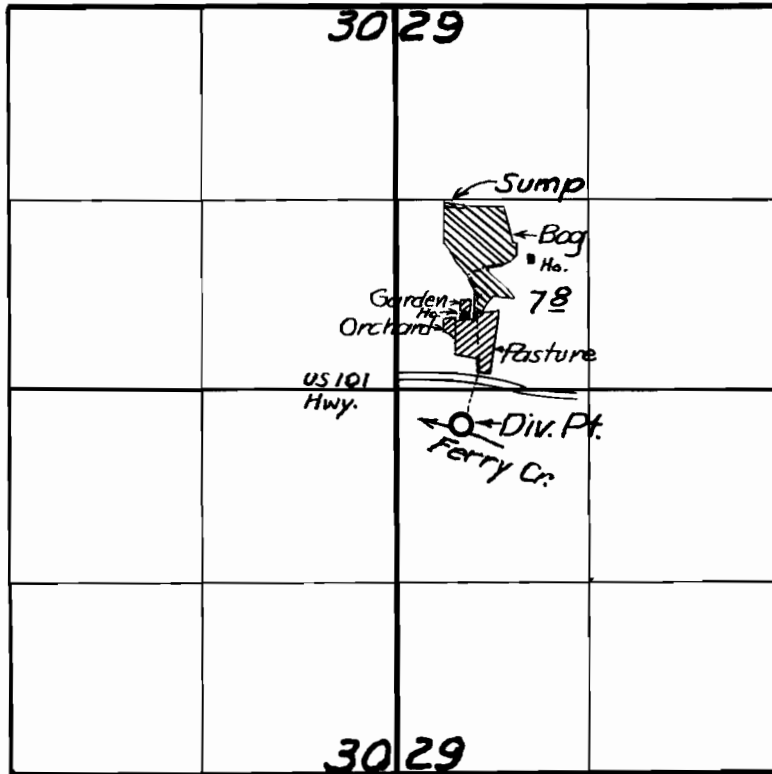

 HUTCHENS 5⁶Ac.
 ROSENBLAD 2²Ac.

FINAL PROOF SURVEY
UNDER

Application No. 21915 Permit No. 17380
IN NAME OF

K. Rosenblad & Alice S. Hutchens

Surveyed Aug 19 & 20 1955, by *M. Bish*