


T. 28S., R. 14W., W.M.

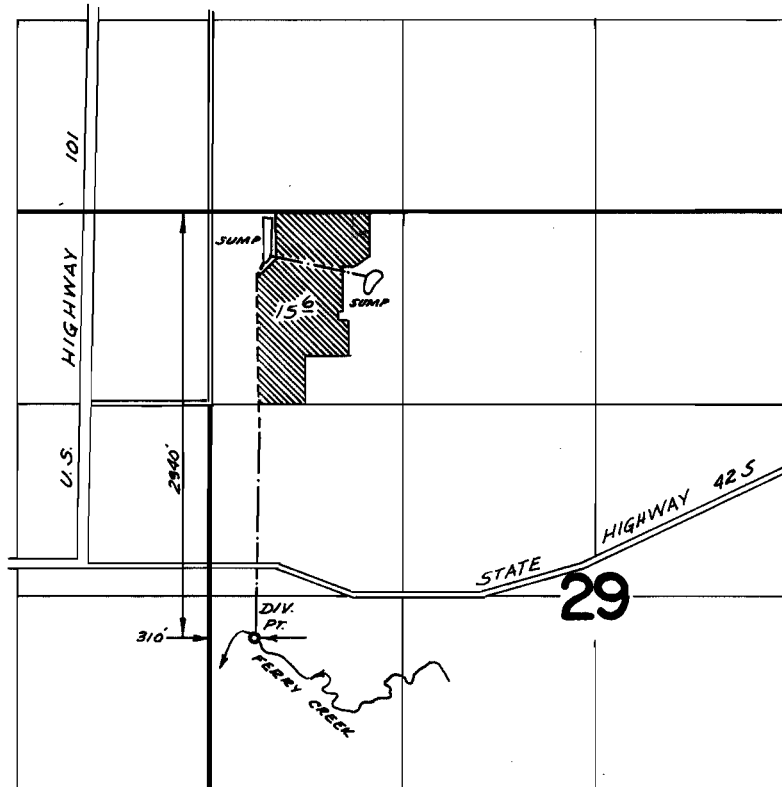

FINAL PROOF SURVEY UNDER

Application No. 44605 Permit No. 33423
IN NAME OF

BATES CRANBERRIES, INC.

Surveyed July 19, 1972, by L. E. Gould