


# T. I. S. R. I. W. W. M.

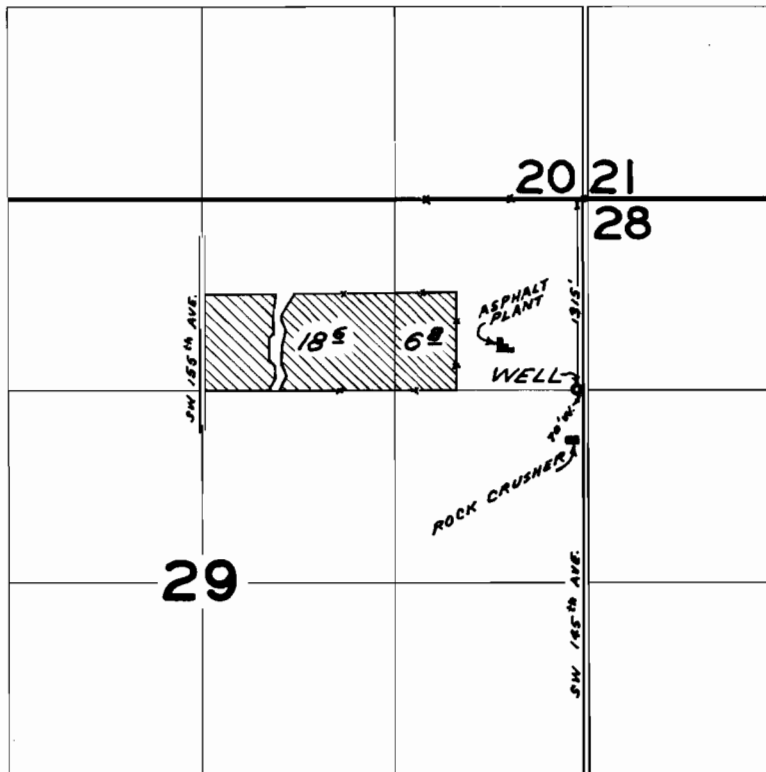

## FINAL PROOF SURVEY UNDER

Application No. G-2641 Permit No. G-2485  
IN NAME OF

LYLE H. COBB

Surveyed SEP. 15 1967, by V. GARNER