


T. 28 S. R. 14 W. W. M.

JAN 04 1988

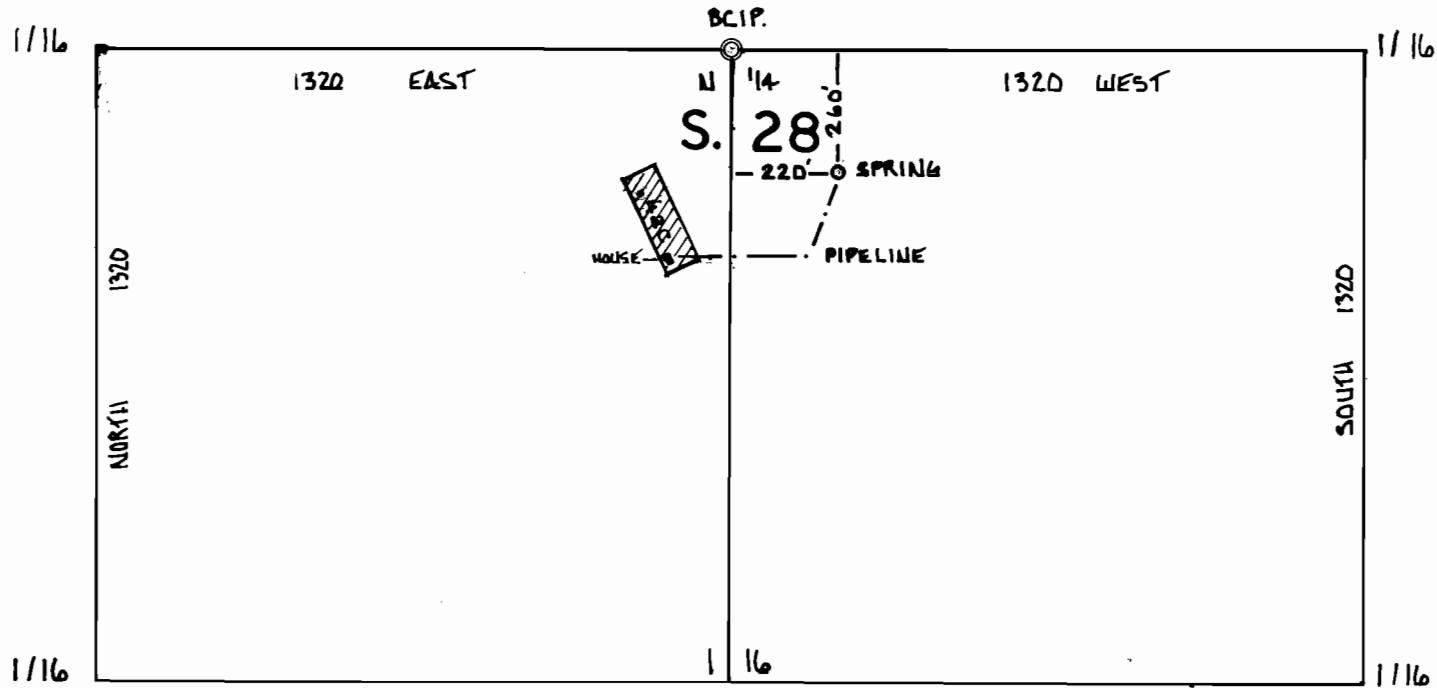

1" = 400'

FINAL PROOF SURVEY UNDER

APPLICATION
7 0 1 1 1

PERMIT
5 1 0 2 1

IN THE NAME OF
DONALD H. O'NEILL



SURVEYED BY : CWRE # 107