


T.6S. R.6W.W.M.

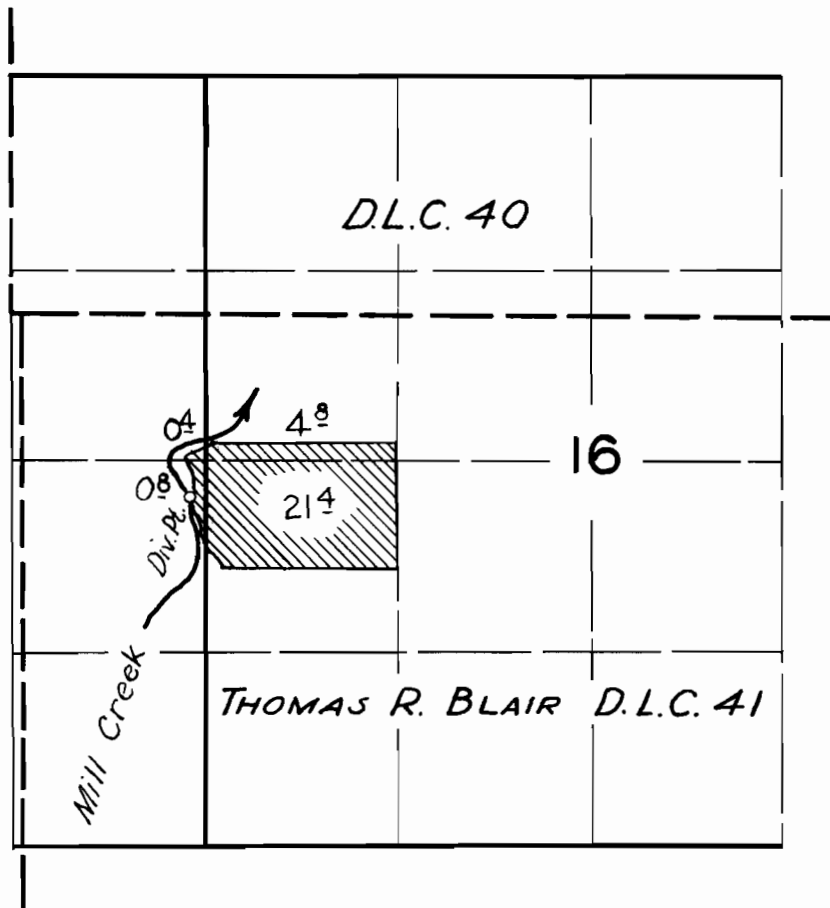

FINAL PROOF SURVEY
UNDER

Application No. 22722 Permit No. 18028
IN NAME OF

DOYLE H. ALLBAUGH

Surveyed April 7 1958, by R.H. Whitby.