
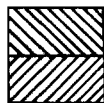


# T.6S. R.1W. W.M.

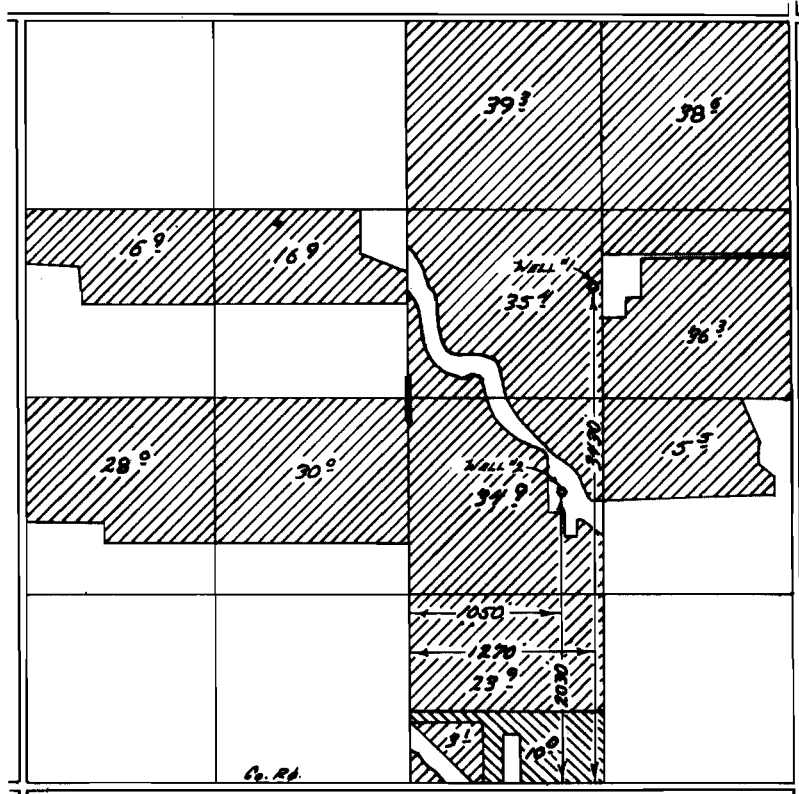

PRIMARY WELL #1

SUPPLEMENTAL WELL #2

## FINAL PROOF SURVEY UNDER

Application No. G-4916 Permit No. G-4633  
IN NAME OF

JAMES BUTSCH

Surveyed May 21 1973, by T. J. Paul