


UNITED STATES  
DEPARTMENT OF THE INTERIOR  
BUREAU OF LAND MANAGEMENT

SECTION

NE 4 NW 4 /


TOWNSHIP 38-S, RANGE 25-E, W. M.

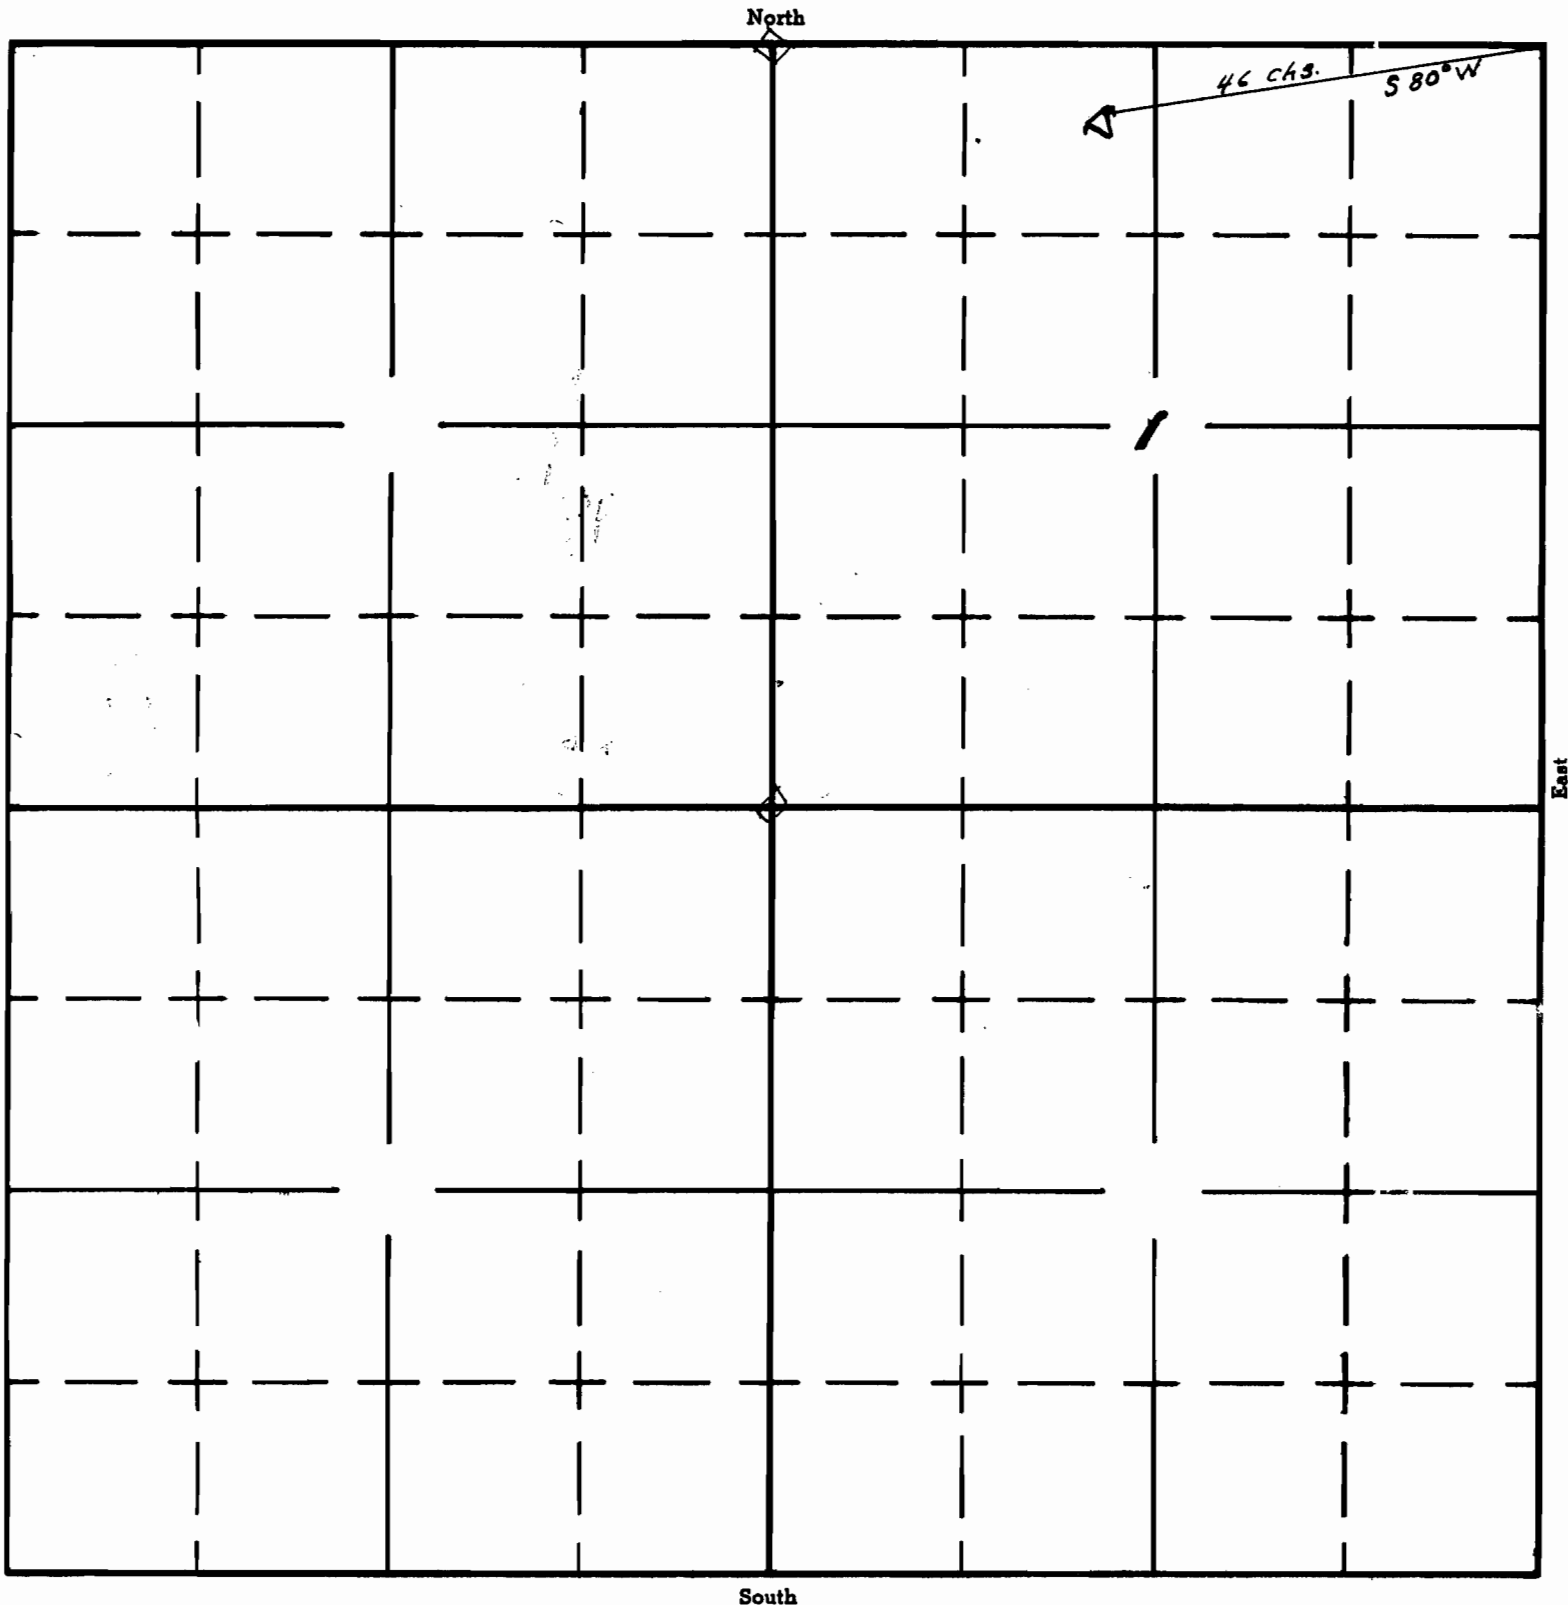

APPLICATION No. R-34701  
PERMIT No. R-2800