

UNITED STATES
DEPARTMENT OF THE INTERIOR
BUREAU OF LAND MANAGEMENT


SECTION

10

Oregon State Water Filings

TOWNSHIP 38S, RANGE 23E, W. M.

North

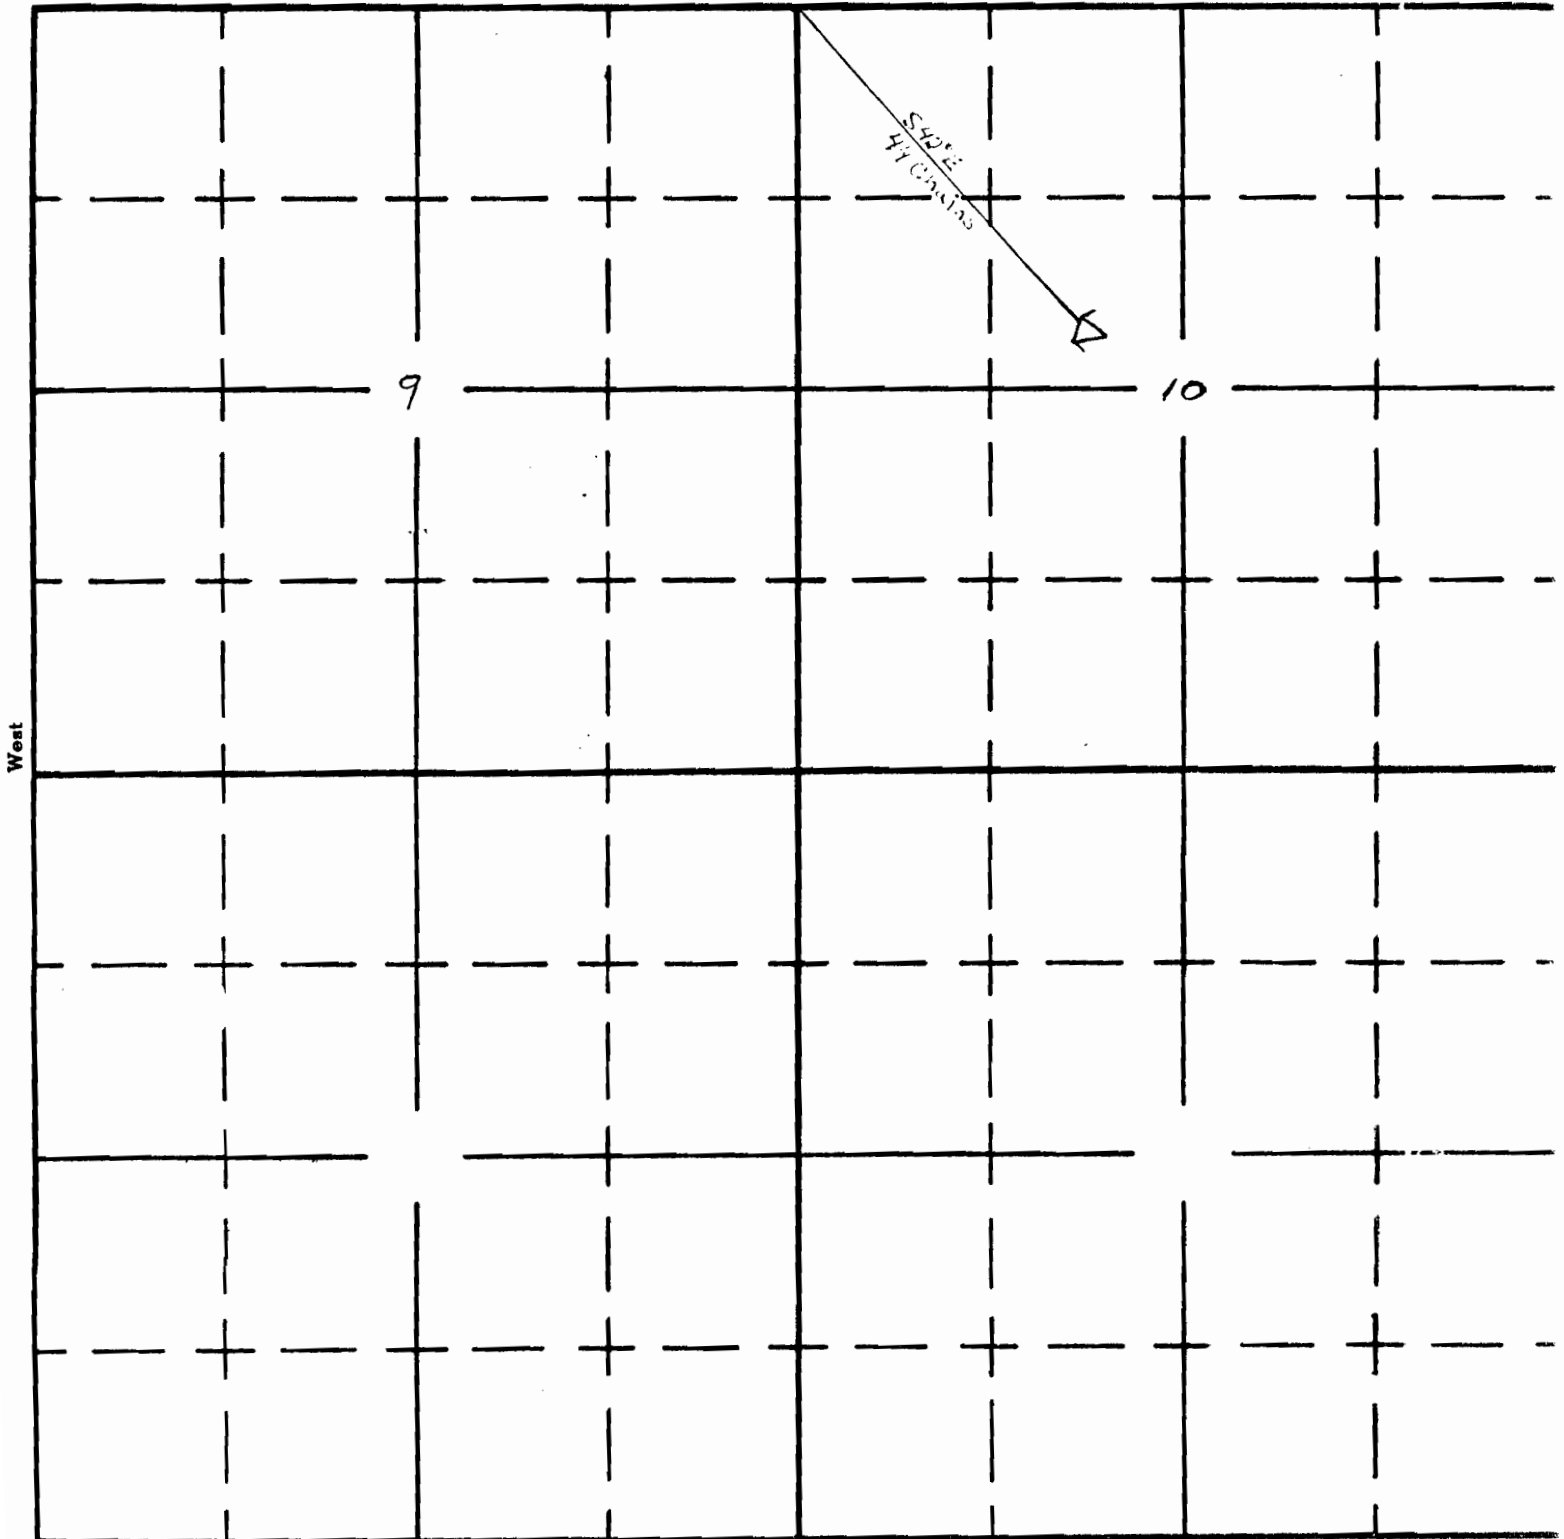


South


APPLICATION No. 1

PERMIT No. R-28