

Form A1-187
March 1961

UNITED STATES
DEPARTMENT OF THE INTERIOR
BUREAU OF LAND MANAGEMENT

RECEIVED
NOV 1 1961
SIXTH DISTRICT
DAVENPORT, IOWA


SECTION

NE NE 35

Oregon State Water Filings

TOWNSHIP 40S, RANGE 25E, W. M.

North

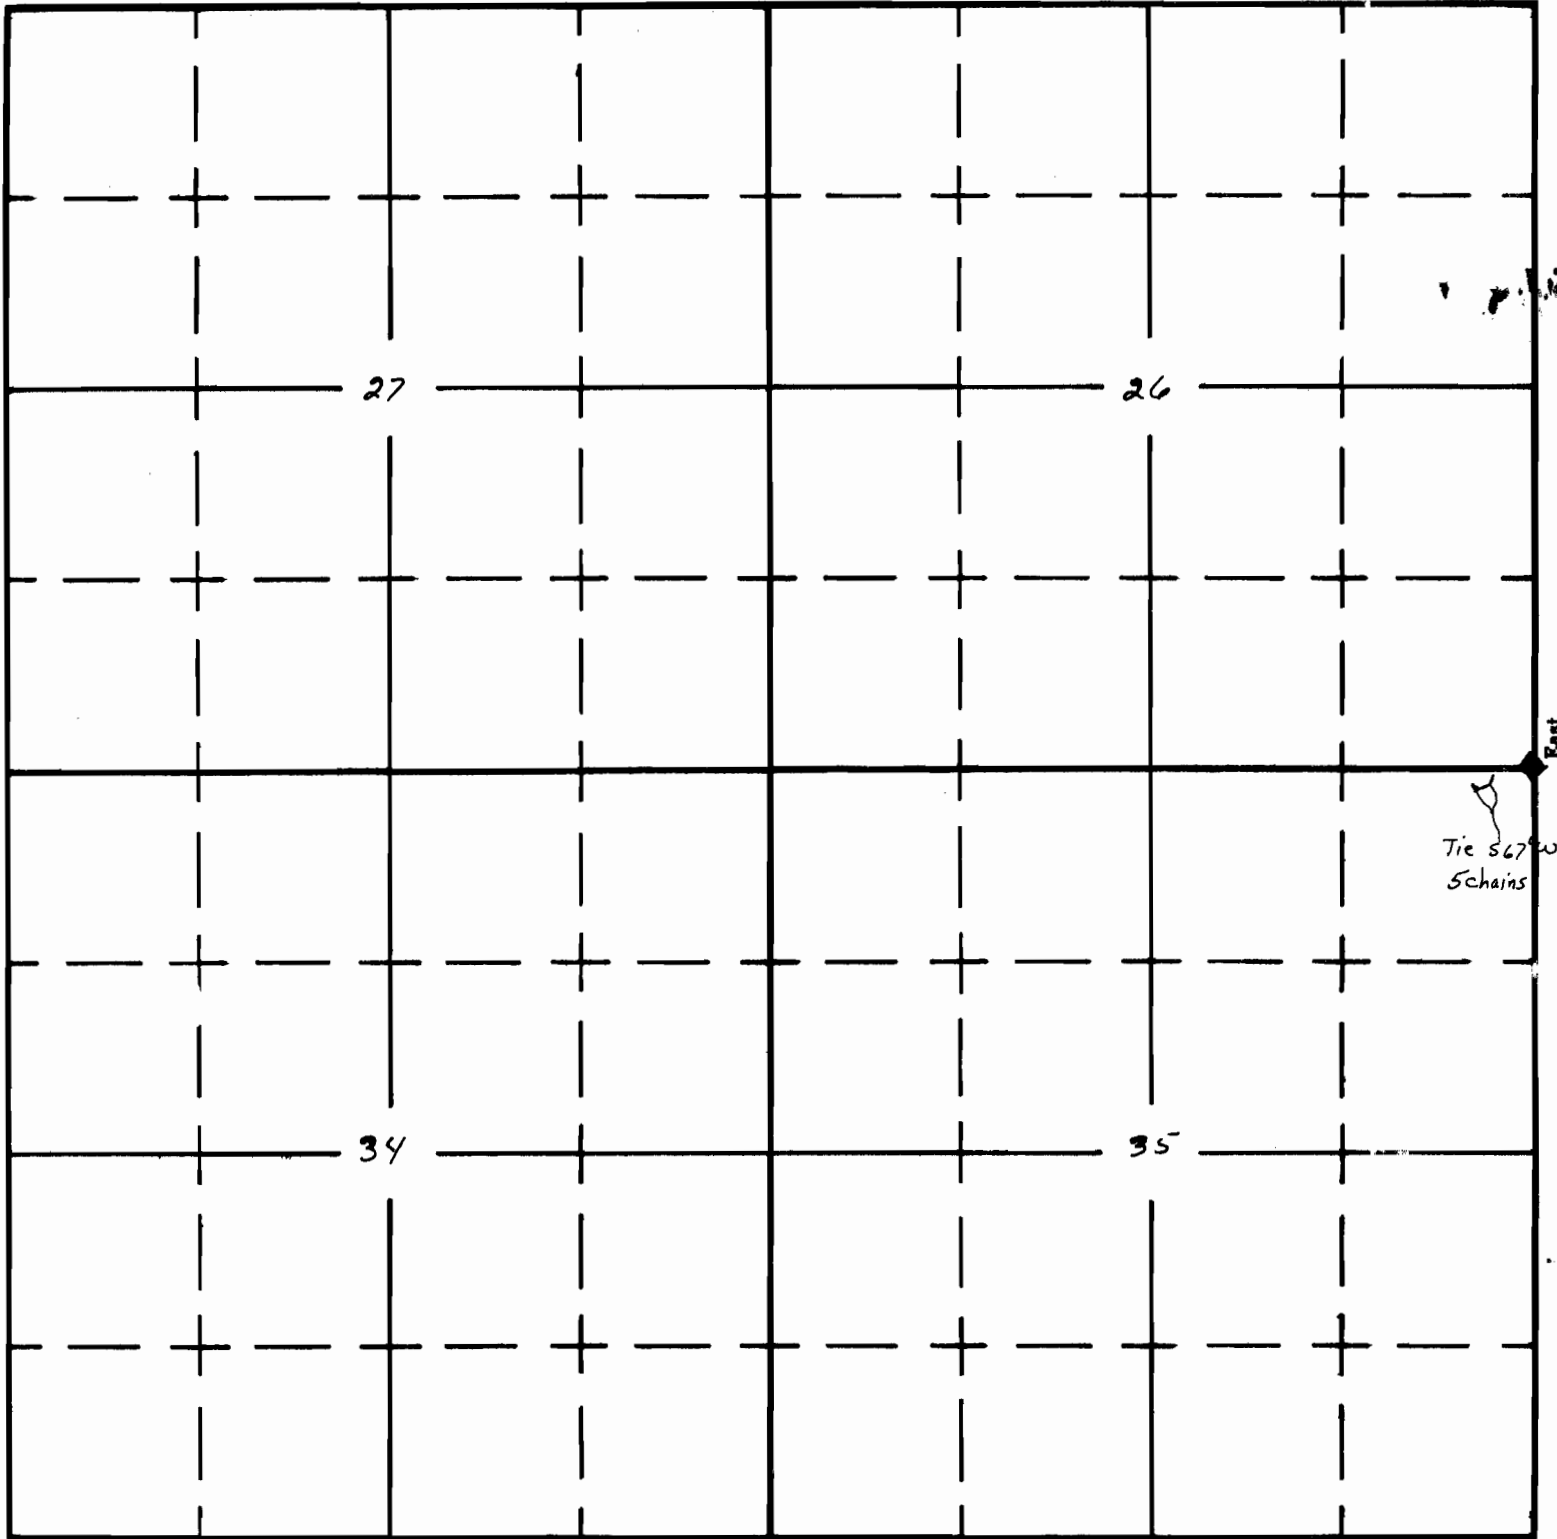

◆ Found survey corner

South

APPLICATION No. R-35205

PERMIT No. **H 6828**