

UNITED STATES
DEPARTMENT OF THE INTERIOR
BUREAU OF LAND MANAGEMENT

SECTION

13

SW 1/4 NE 1/4


Oregon State Water Filings

TOWNSHIP 28S, RANGE 24E, W. M.

North

Tied in with aerial photo and OSMD Quad
maps.

14

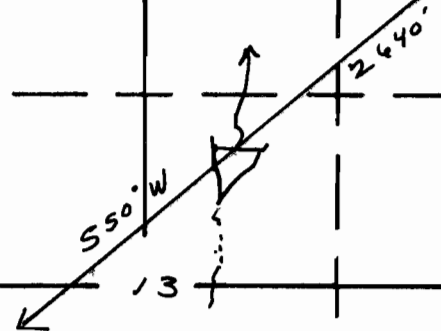

23

24

South

APPLICATION No. R-35310
PERMIT No. R-3064