

UNITED STATES
DEPARTMENT OF THE INTERIOR
BUREAU OF LAND MANAGEMENT

R-6878
67394

SECTION


20

Oregon State Water Filings

NW¹/₄ SW¹/₄

TOWNSHIP 38S, RANGE 26E, W. M.

Tied in with aerial photos and O.S.H. & Quad Maps

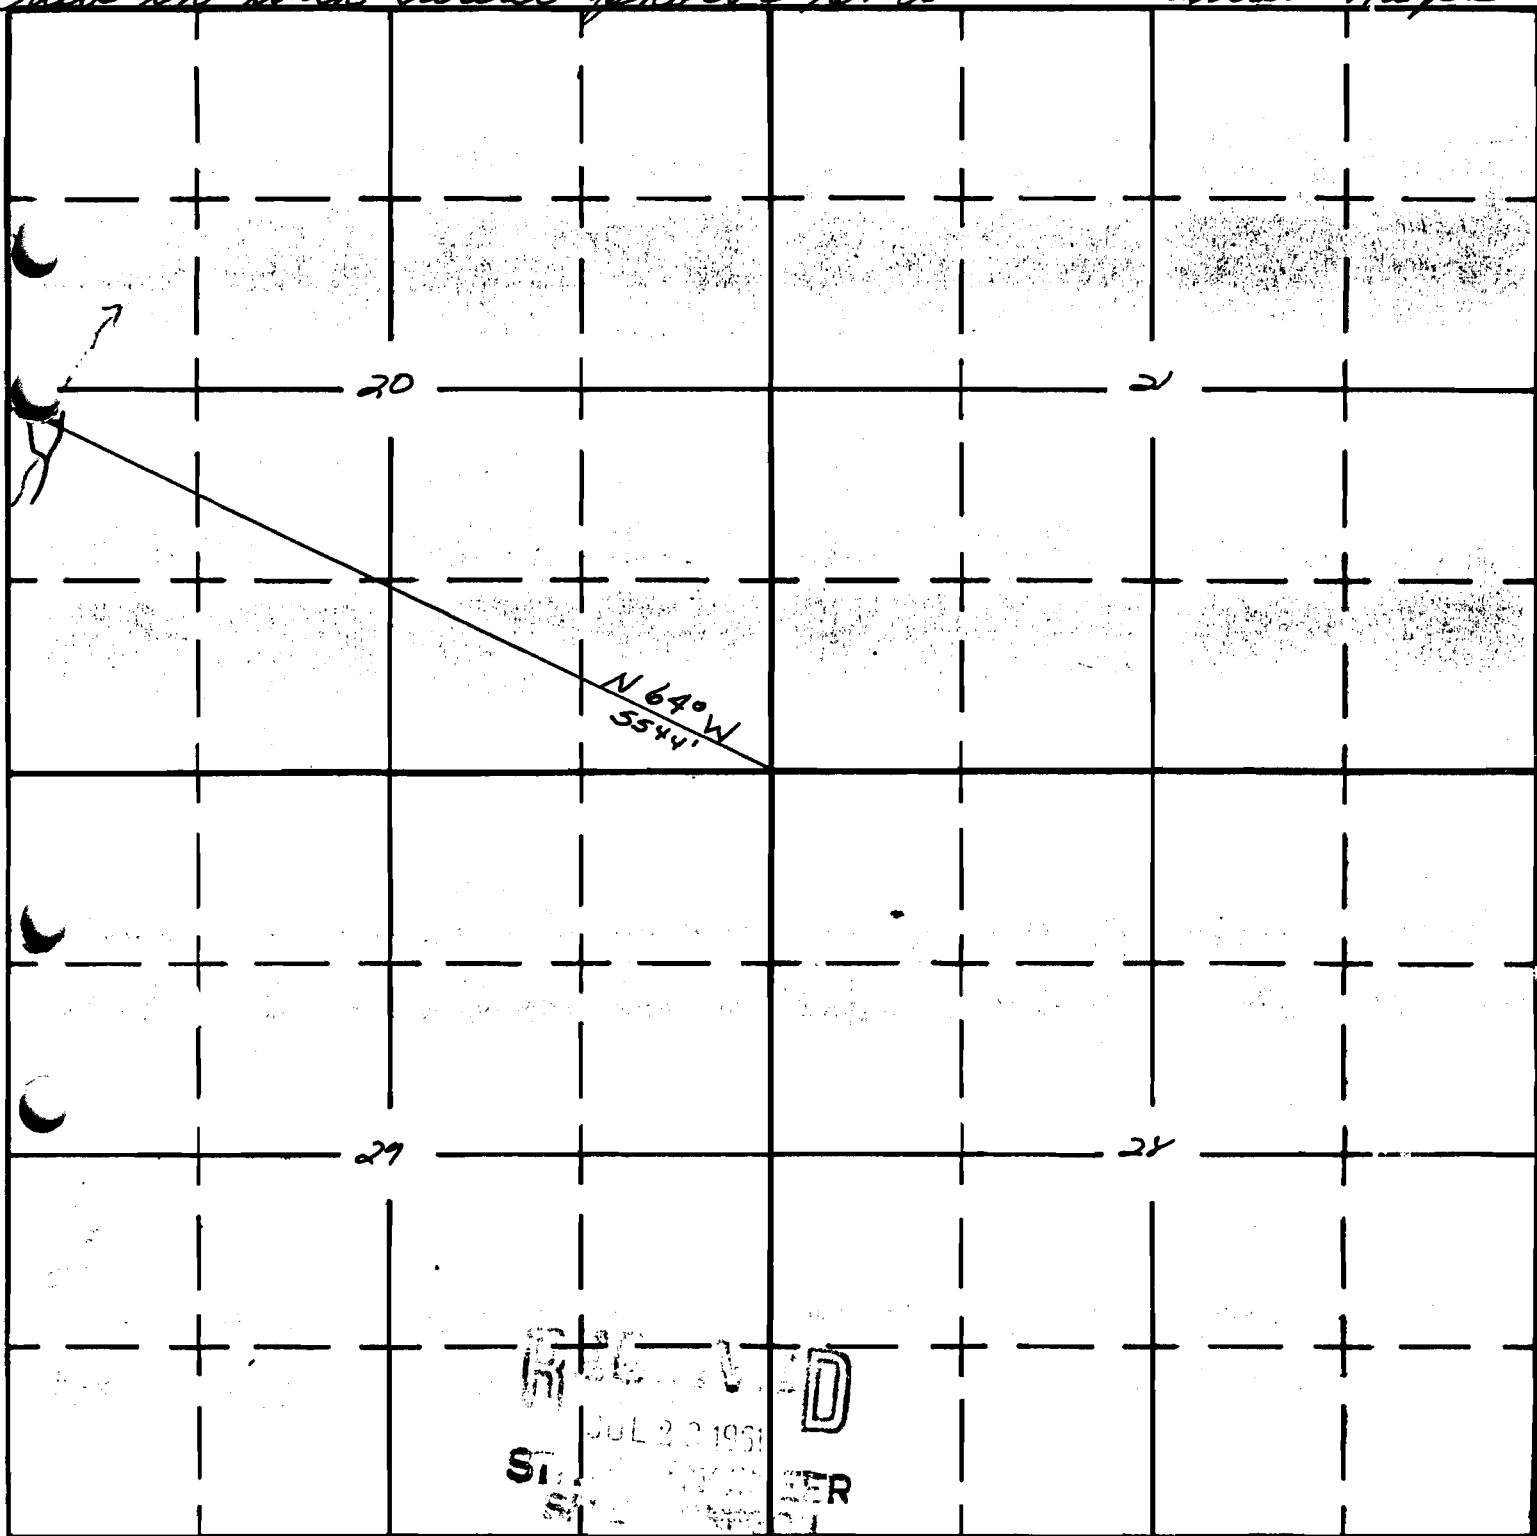

South

APPLICATION No. R-35786

PERMIT No. R 6878