

Form A1-187
March 1961

UNITED STATES
DEPARTMENT OF THE INTERIOR
BUREAU OF LAND MANAGEMENT

R-7037
67398

SECTION


5

SE 1/4 SW 1/4

Oregon State Water Filings

TOWNSHIP 3/S, RANGE 24E, W. M.

North Tied in with aerial photo and OS&O Quad Maps.

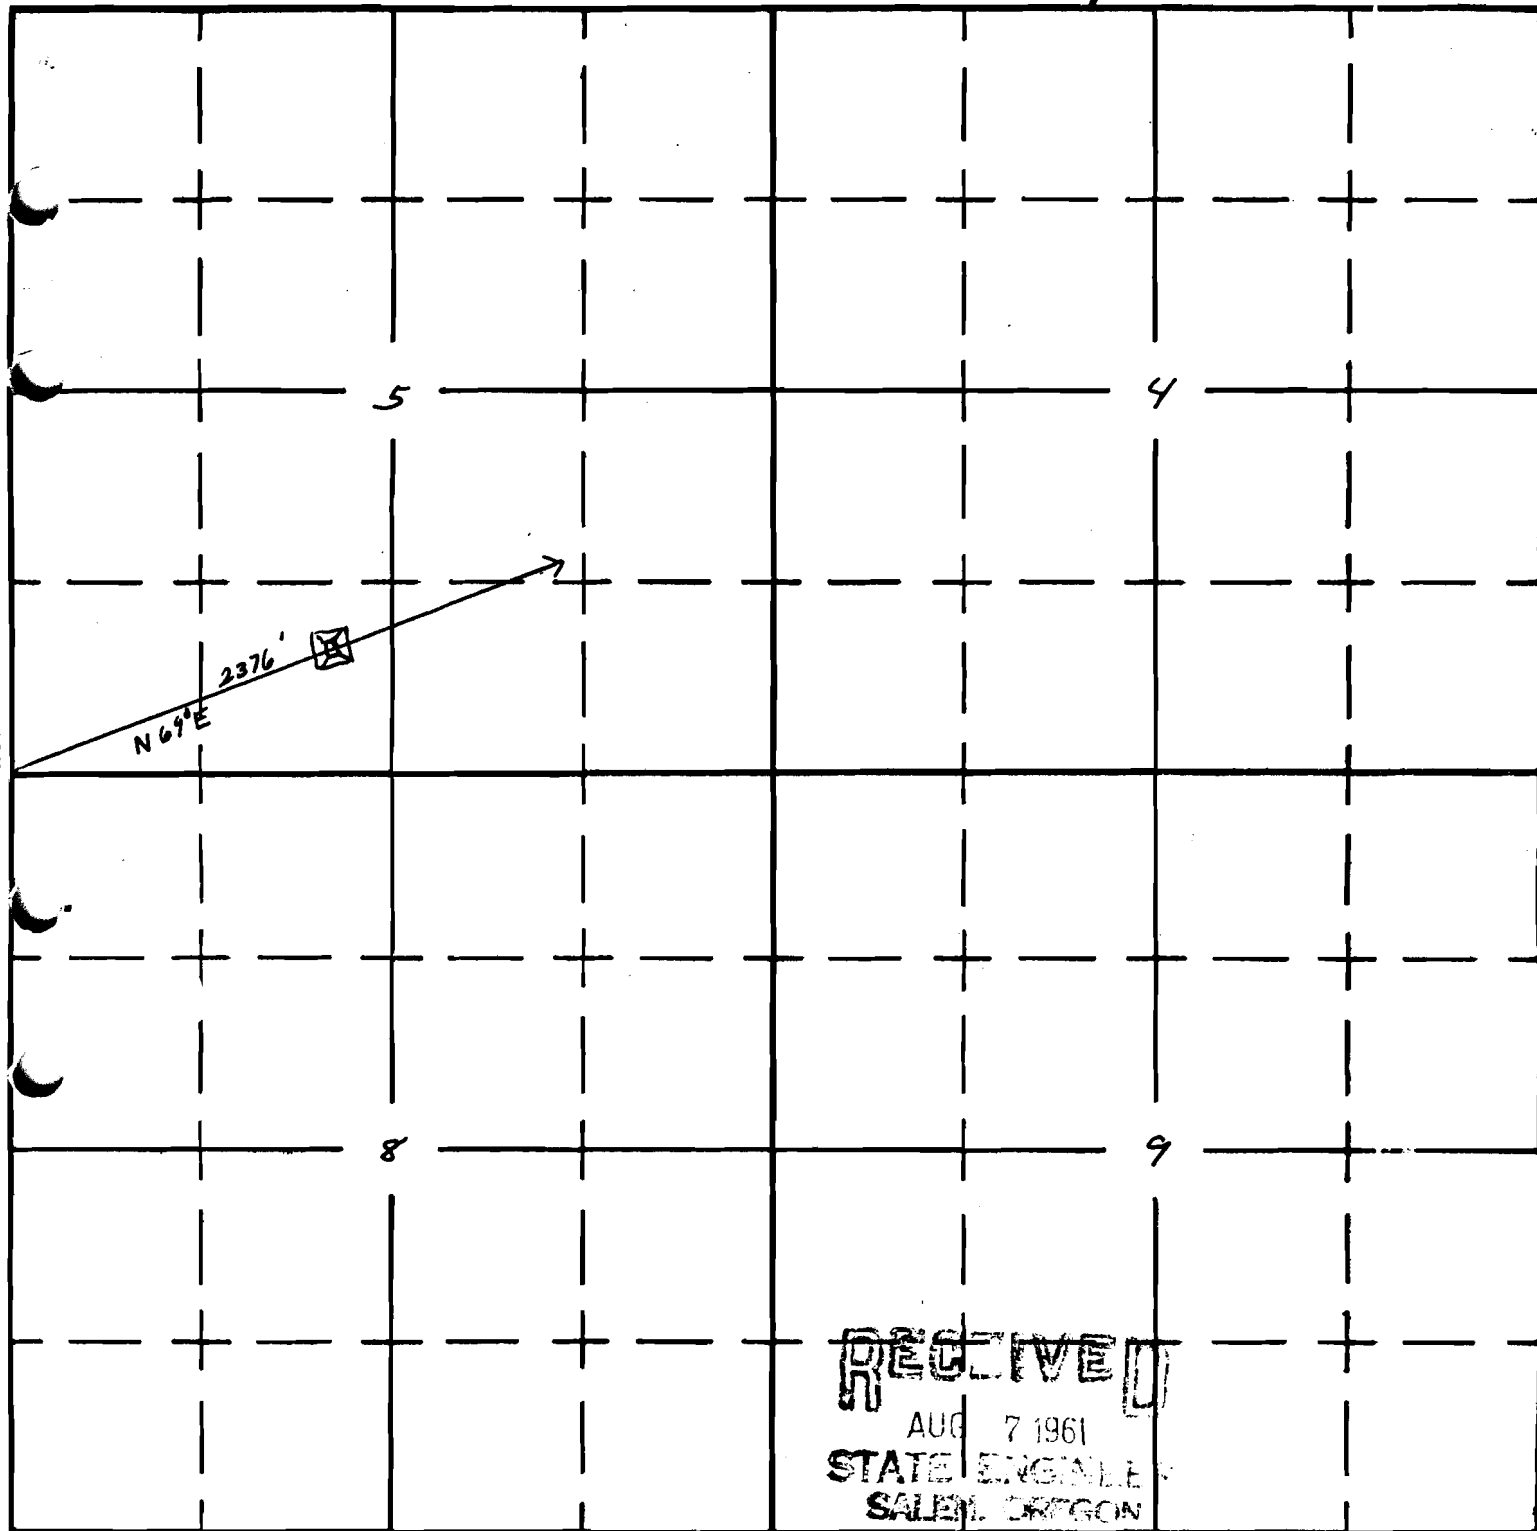

South

APPLICATION No. R-36174
PERMIT No. 7037