

UNITED STATES
DEPARTMENT OF THE INTERIOR
BUREAU OF LAND MANAGEMENT


SECTION 18

Oregon State Water Filings

NW 1/4 SE 1/4

TOWNSHIP 33 S, RANGE 23E, W. M.

Tied in with aerial photos & O.S.H.D. Quad Maps

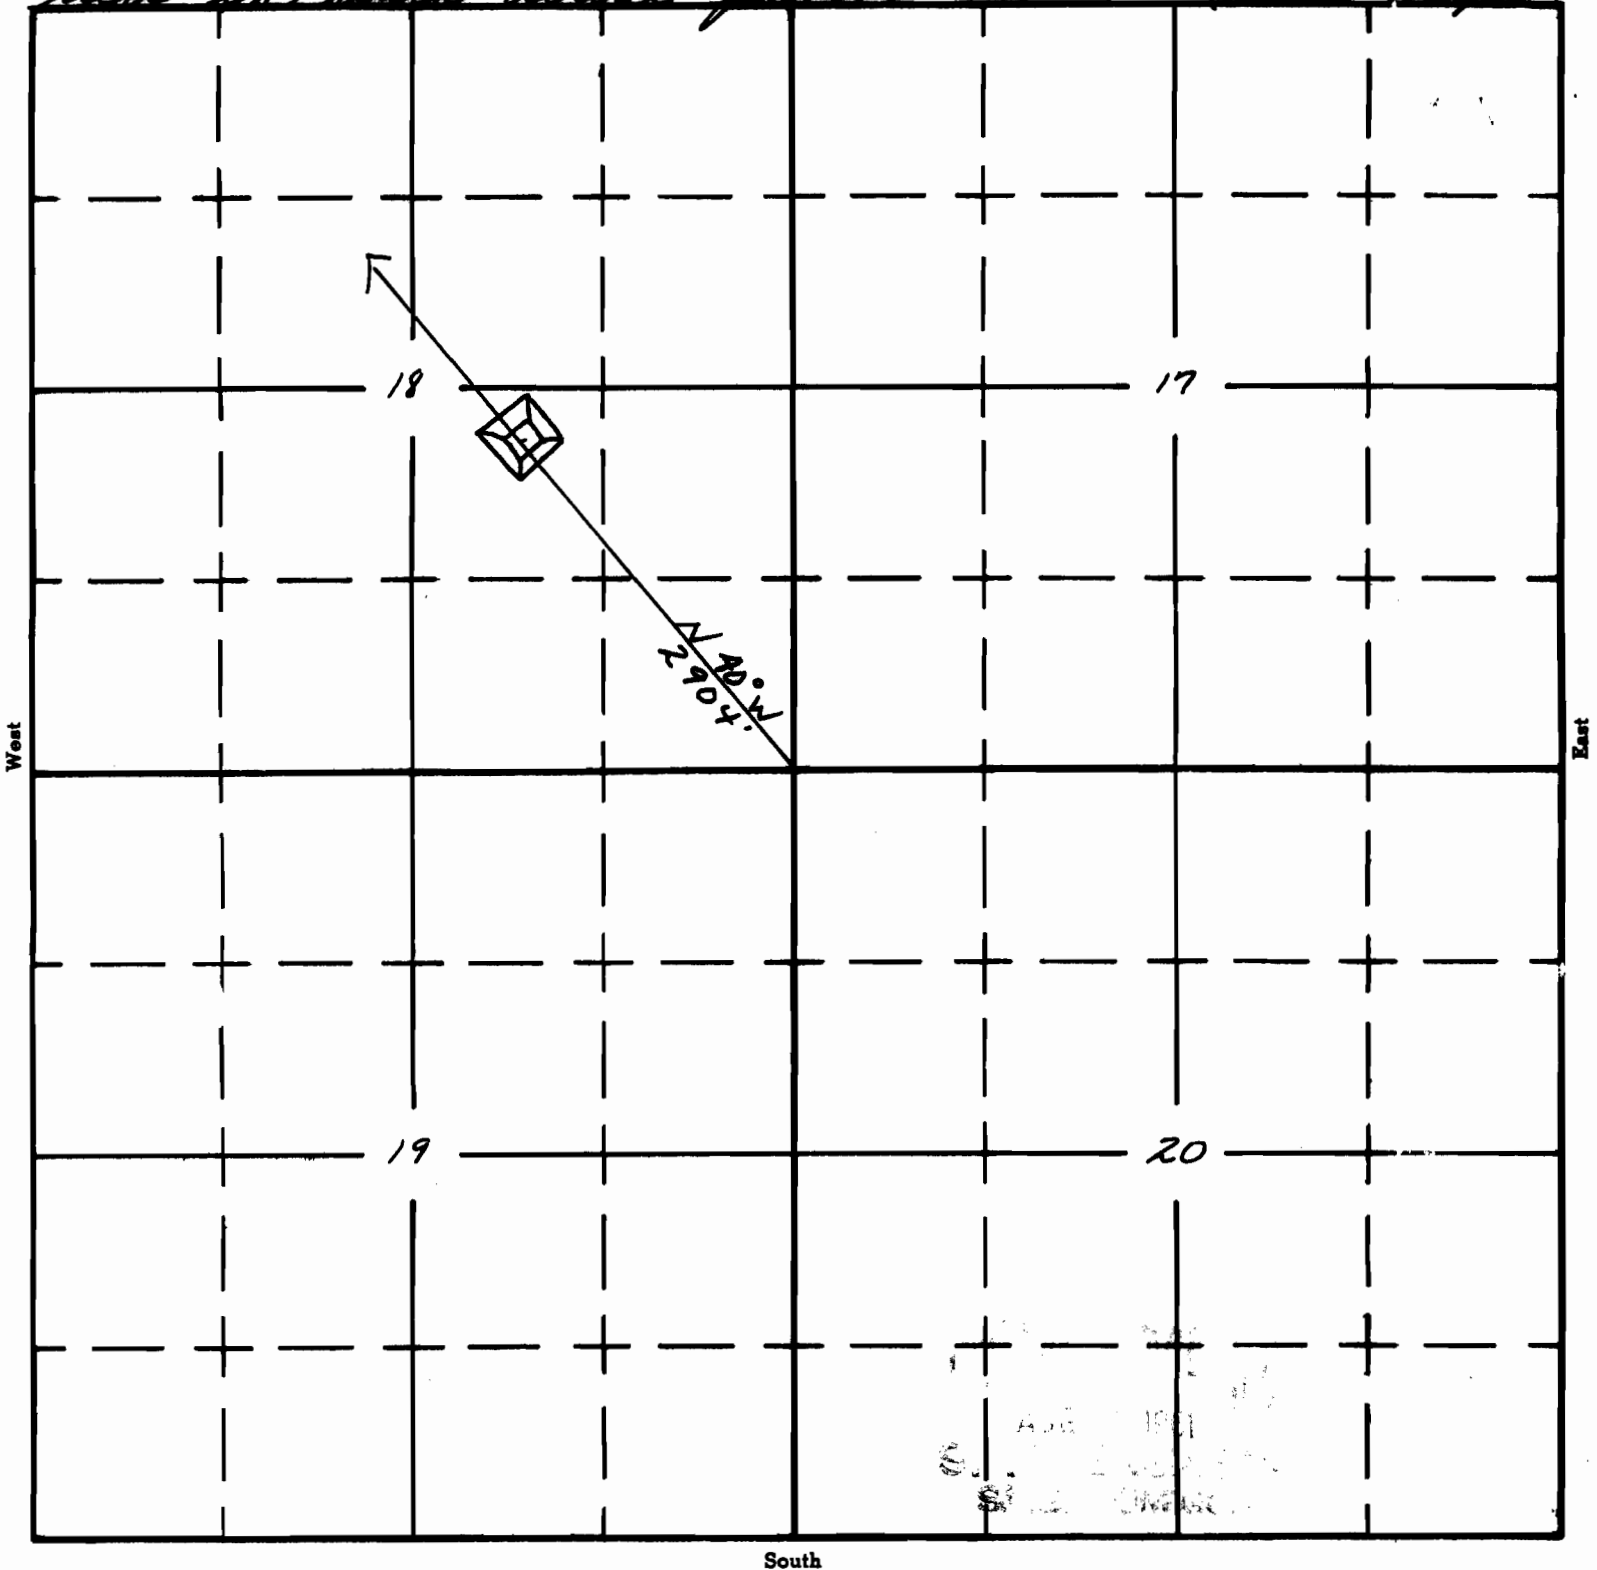

South

APPLICATION No. R-36207
PERMIT No. R 7060